


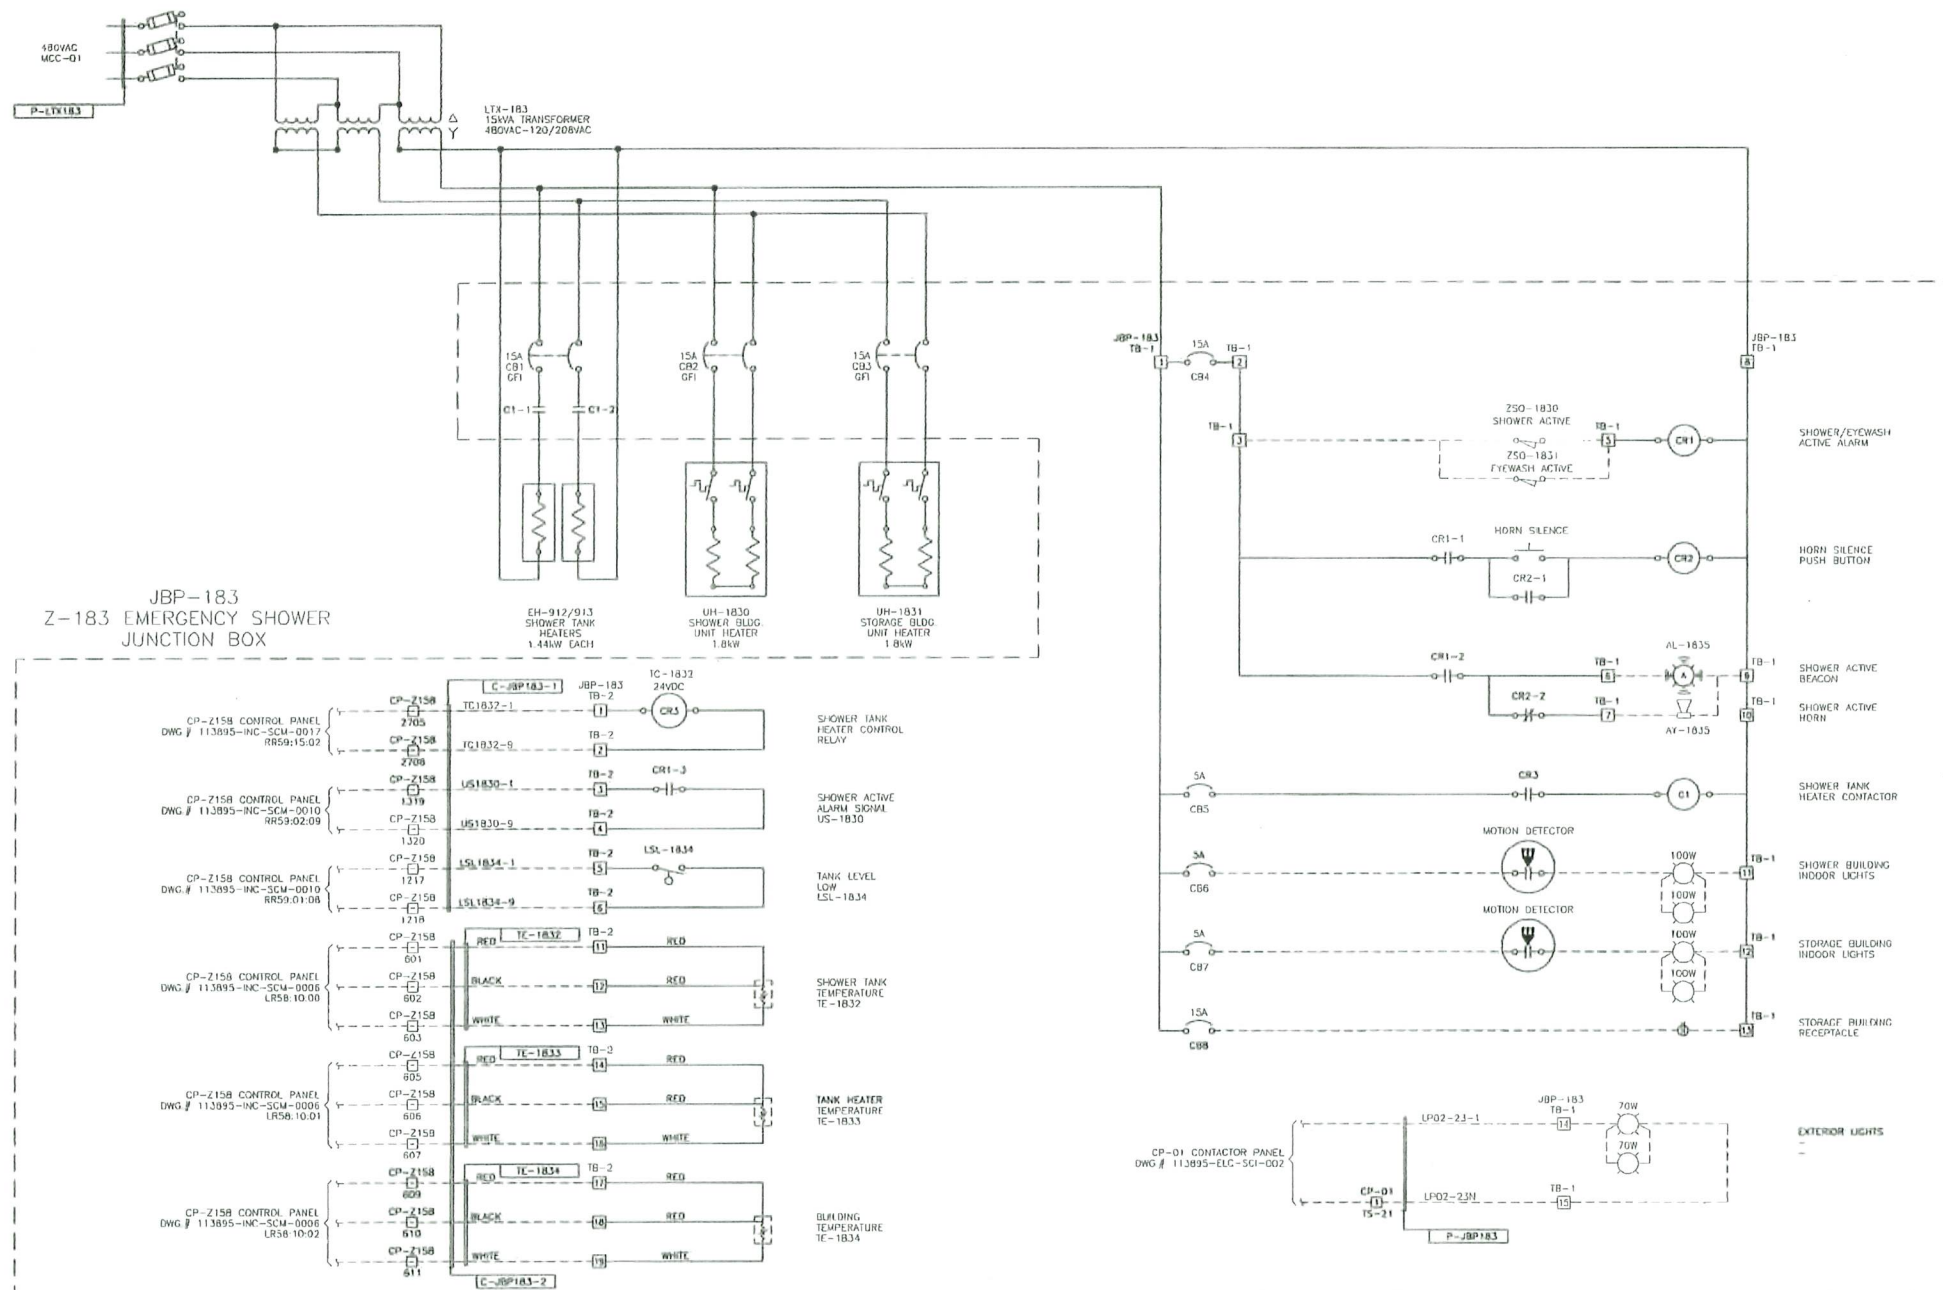

NOTES:

ISSUED FOR
SEP 19 2013
INFORMATION

1	AS BUILT	07/04/13	YC	NC	SDJ
0	ISSUED FOR CONSTRUCTION	09/09/13	WCF	-	-
REV	DESCRIPTION	DATE	BY	CHK	APP
ZARGON OIL & GAS LTD.					
ECO-Technica Inc. Edmonton, Alberta, Canada www.eco-technica.com					
TITLE LITTLE BOW ASP FACILITY LSD 16-31-14-18 W4M WIRING DIAGRAM JBP-183					
DRAWN:	WCF	DATE:	25APR13	SCALE:	NIS
DESIGN:	-	DATE:	-	CAD FILENAME:	-
CHECKED:	-	DATE:	-	E130016CP	-
APPROVED:	-	DATE:	-	DRAWING SIZE	-
CLIENT APPR:	-	DATE:	-	-	-
DRAWING NUMBER: 113896-ELC-WDC-0001					REV. 1

