


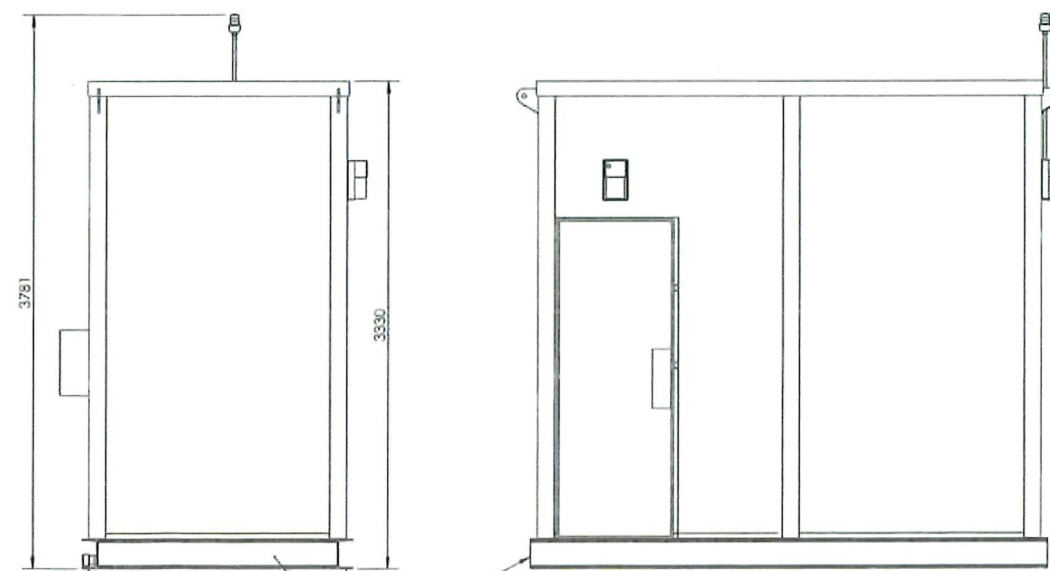
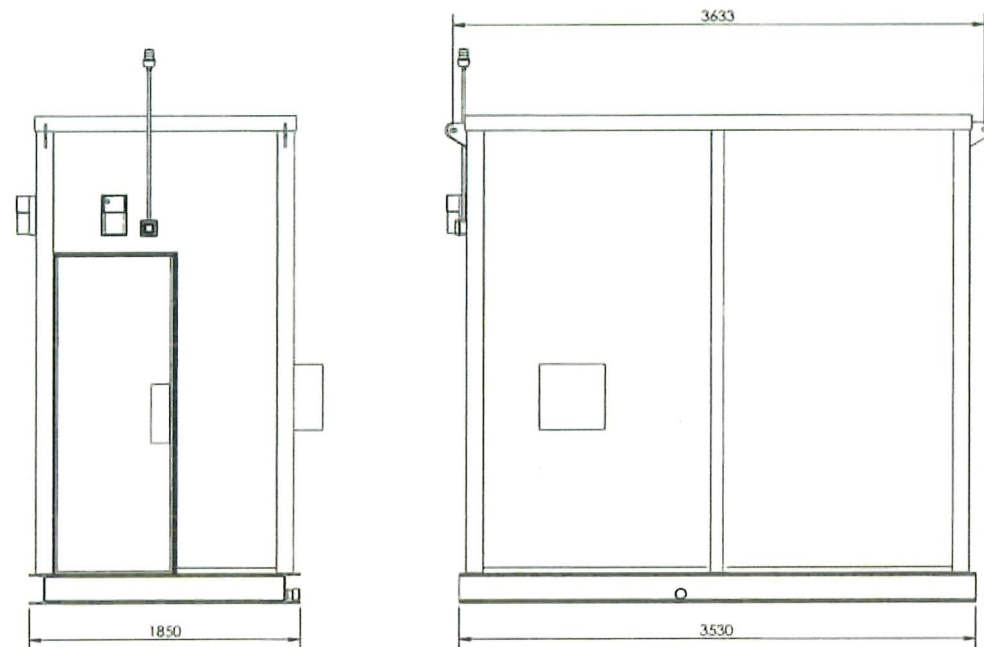
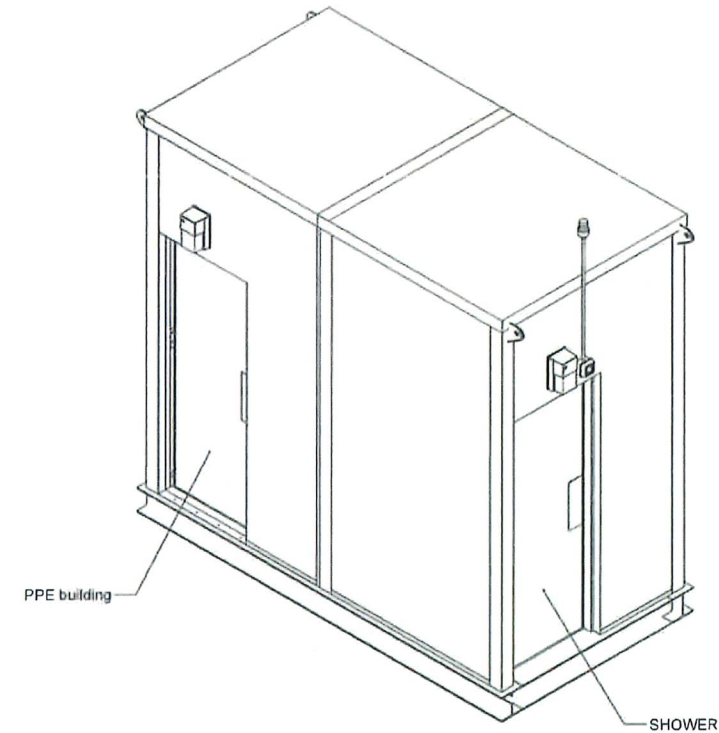


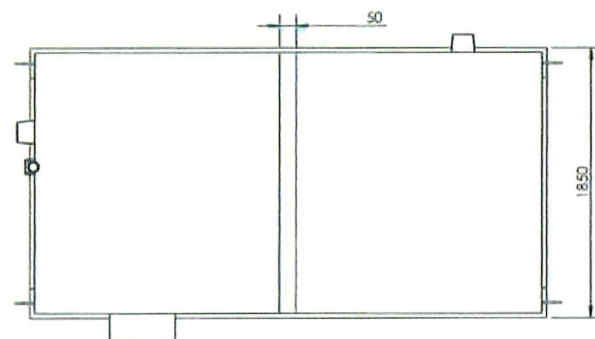

W8x31, CSA G40.21-350W
FLOOR SUPPORTS ARE 6 L3x3x3/16"
AND ONE W8x31 MID-SPAN
ALL MATERIALS CSA G40.21-350W

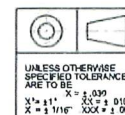

NOTES:

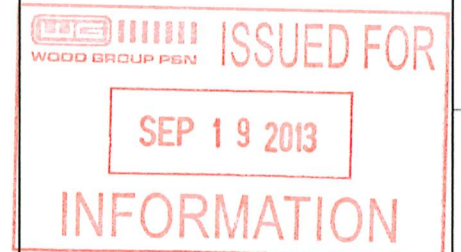

REV	DESCRIPTION	DATE	BY	CHK	APP
1	ISSUED FOR CONSTRUCTION	2013/02/20	AT	MD	DK
2	ISSUED FOR FABRICATION	2013/02/20	AT	MD	DK
3	ISSUED FOR INSTALLATION	2013/02/20	AT	MD	DK
4	ISSUED FOR COMPLETION	2013/02/20	AT	MD	DK
5	ISSUED FOR AS-BUILT	2013/02/20	AT	MD	DK

ZARGON OIL & GAS LTD.
LITTLE BOW ASP FACILITY
LSD: 16-31-14-18 W4M



ECO-Technica Inc.
Edmonton, Alberta,
Canada
www.eco-technica.com

TITLE: EMERGENCY SAFETY SHOWER, GA Z-183 CONFIGURATION			
DRAWN: AT	DATE: 2013/02/20	SCALE: 1:24	
DESIGN: AT	DATE: 2013/02/20		
CHECKED: MD	DATE: XXX		
APPROVED: DK	DATE: XXX		
CLIENT APPR: XX	DATE: XXX	DRAWING SIZE: D	
DRAWING NUMBER: E124516CP-S-SS-004	REV: 0		