


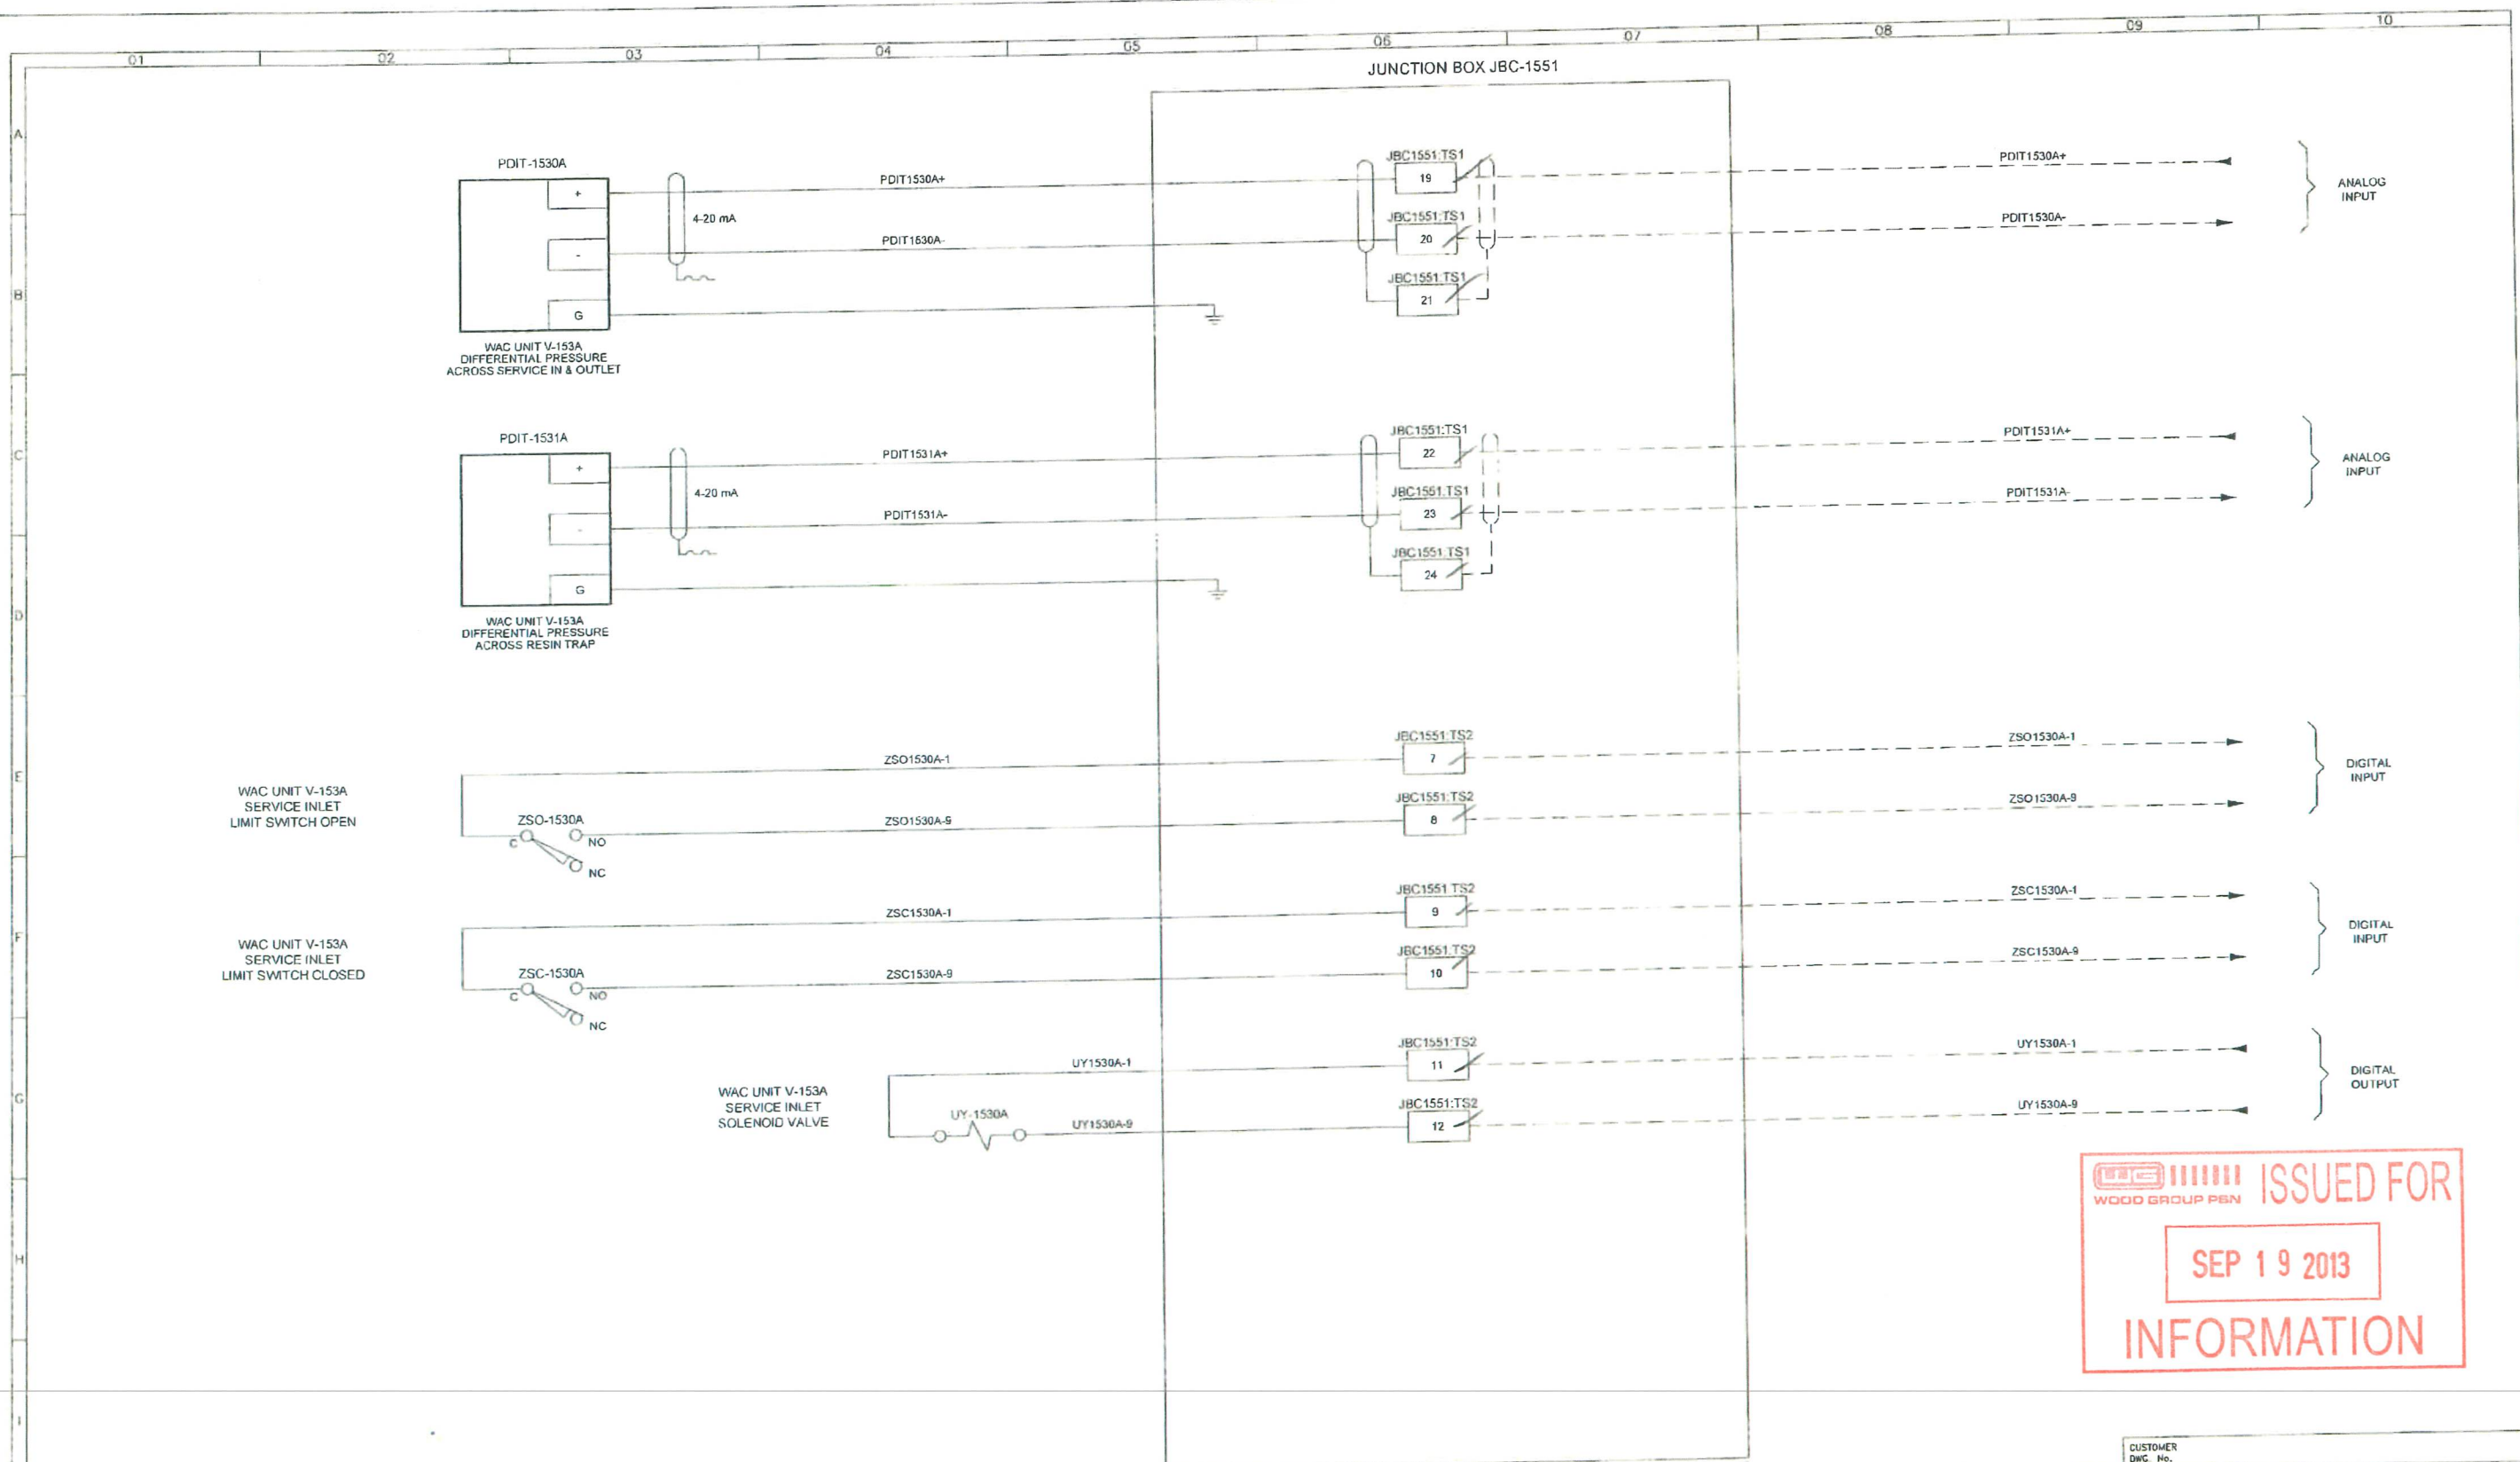

ISSUED FOR
SEP 19 2013
INFORMATION

THIS DRAWING AND ALL INFORMATION AND KNOWLEDGE CONTAINED OR REFERRED HEREIN ARE THE CONFIDENTIAL AND PROPRIETARY PROPERTY OF ANDERSON WATER SYSTEMS, INC. ("AWS") AND AS SUCH ARE INSTRUMENTS OF SERVICE FOR USE SOLELY WITH RESPECT TO THIS PROJECT. THESE INSTRUMENTS OF SERVICE SHALL NOT BE REPRODUCED, TRANSMITTED, DISCLOSED OR USED OTHERWISE IN WHOLE OR IN PART WITHOUT THE WRITTEN AGREEMENT BY AWS AND MUST BE RETURNED OR DESTROYED UPON REQUEST.

REV	REVISION DESCRIPTION	DRWN	CHKD	APP	DATE
A	ORIGINAL ISSUE	SS	JW	DP	NOV 12
B	CUSTOMER COMMENTS ADDED	SS	JW	DP	JAN 13
C	REVISED PER CUSTOMER COMMENTS	SS	JW	DP	MAY 13
D	AS BUILT	SS	JW	DP	JUN 13

REV	REVISION DESCRIPTION	DRWN	CHKD	APP	DATE


PROJECT INFORMATION
ZARGON UTILE BOW ASP FACILITY
LSD 16-31-14-1B W4M
ALBERTA, CANADA
CONTRACT NUMBER
120128

ANDERSON WATER SYSTEMS
44 Head St., Dundas, Ontario
L9H 3H3 Canada
Phone: +1 (805) 627-9233
www.AWSL.com

BY	DATE
DRWN: SS	NOV 12
CHKD: JW	NOV 12
APP: DP	NOV 12
REF:	
SCALE:	
TOTAL NUMBER OF LOOP PAGES:	17

CUSTOMER Dwg. No.	
LOOP DIAGRAM	
WEAK ACID CATION	
UNIT V-153A	
SIZE	B
DWG. NO.	120128-0919-1-LOOP-003
REV.	D

ISSUED FOR
SEP 19 2013
INFORMATION

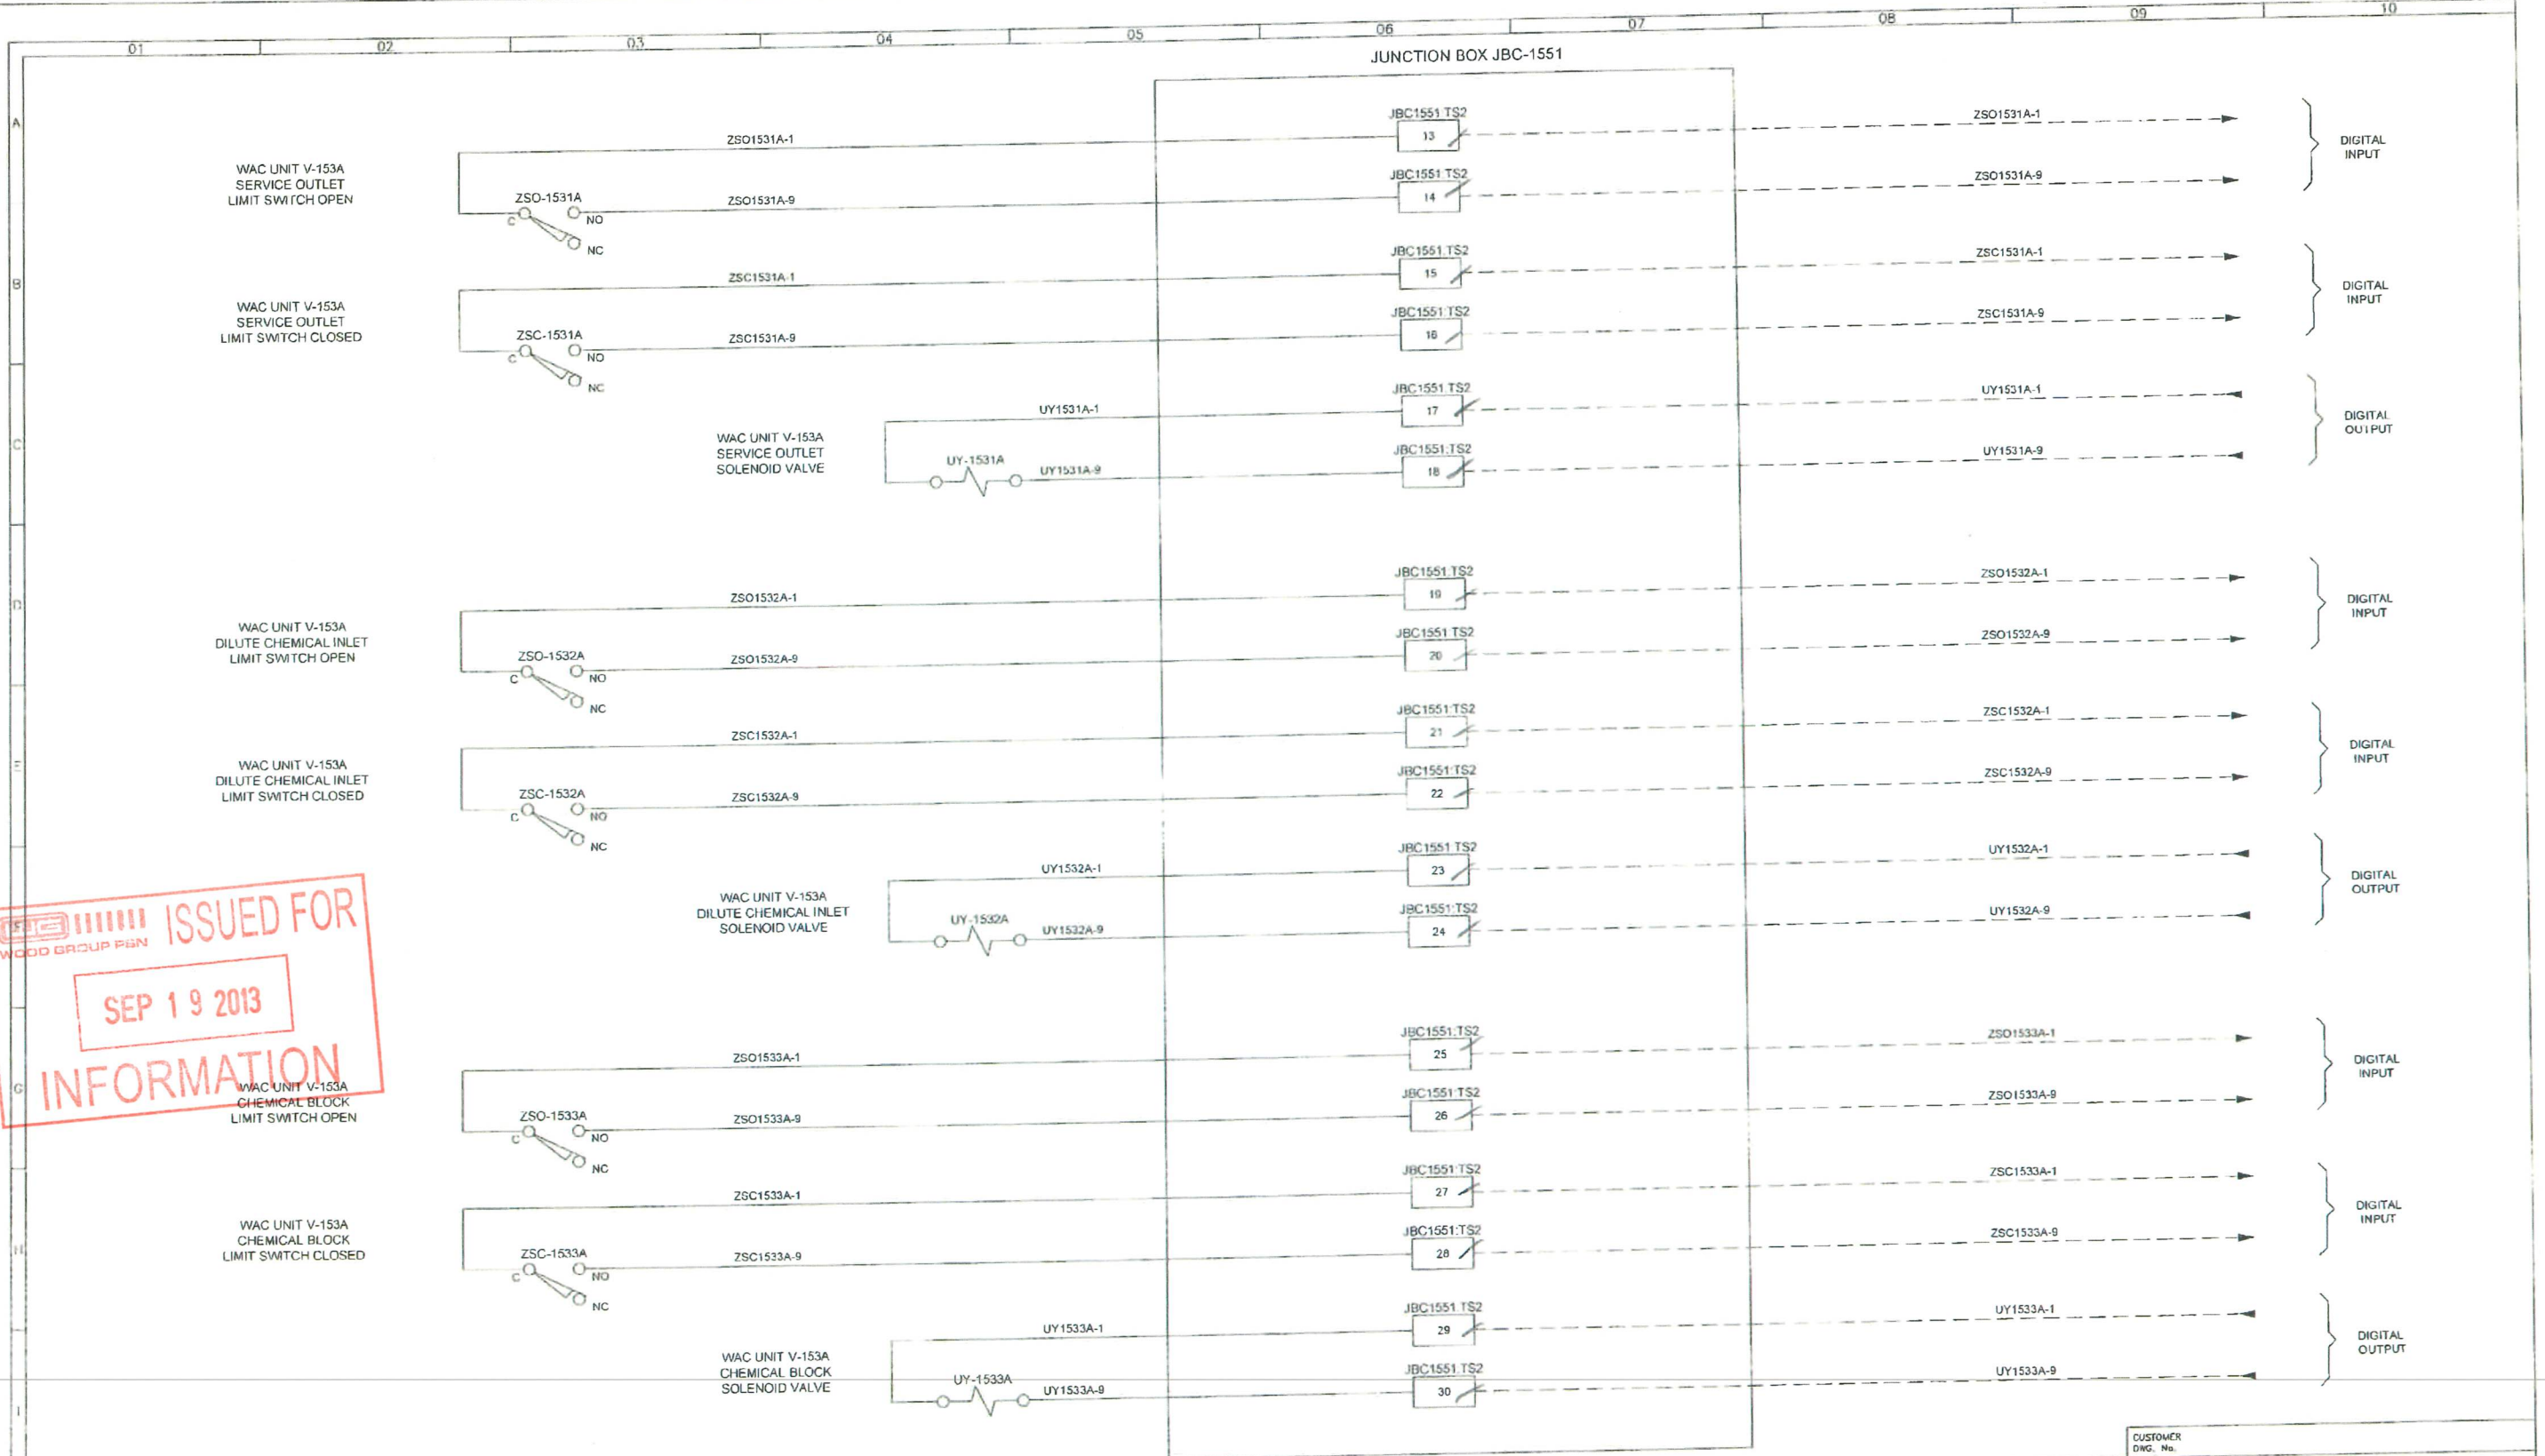

THIS DRAWING AND ALL INFORMATION AND KNOWLEDGE CONTAINED OR REFERRED HEREIN ARE THE CONFIDENTIAL AND PROPRIETARY PROPERTY OF ANDERSON WATER SYSTEMS, INC. ("AWS") AND AS SUCH ARE INSTRUMENTS OF SERVICE FOR USE SOLELY WITH RESPECT TO THIS PROJECT. THESE INSTRUMENTS OF SERVICE SHALL NOT BE REPRODUCED, TRANSMITTED, DISCLOSED OR USED OTHERWISE IN WHOLE OR IN PART WITHOUT THE WRITTEN AGREEMENT BY AWS AND MUST BE RETURNED OR DESTROYED UPON REQUEST.

REV	REVISION DESCRIPTION	DRWN	CHKD	APP	DATE
A	ORIGINAL ISSUE	SS	JW	DP	NOV. 12
B	CUSTOMER COMMENTS ADDED	SS	JW	DP	JAN. 13
C	REVISED PER CUSTOMER COMMENTS	SS	JW	DP	MAY 13
D	AS BUILT	SS	JW	DP	JUN 13


REV	REVISION DESCRIPTION	DRWN	CHKD	APP	DATE

PROJECT INFORMATION
ZARGON LITTLE BOW ASP FACILITY
LSD 16-31-14-18 W4M
ALBERTA, CANADA
CONTRACT NUMBER
120128

ANDERSON WATER SYSTEMS
44 Head St., Dundas, Ontario
L9H 3H3 Canada
Phone: +1 (905) 627-9233
www.AWSL.com

BY	DATE
SS	NOV. 12
JW	NOV. 12
DP	NOV. 12

CUSTOMER	DWG. No.
LOOP DIAGRAM	
WEAK ACID CATION	
UNIT V-153A	
SIZE	B
DWG. NO.	120128-0919-1-LOOP-004
REF.	D

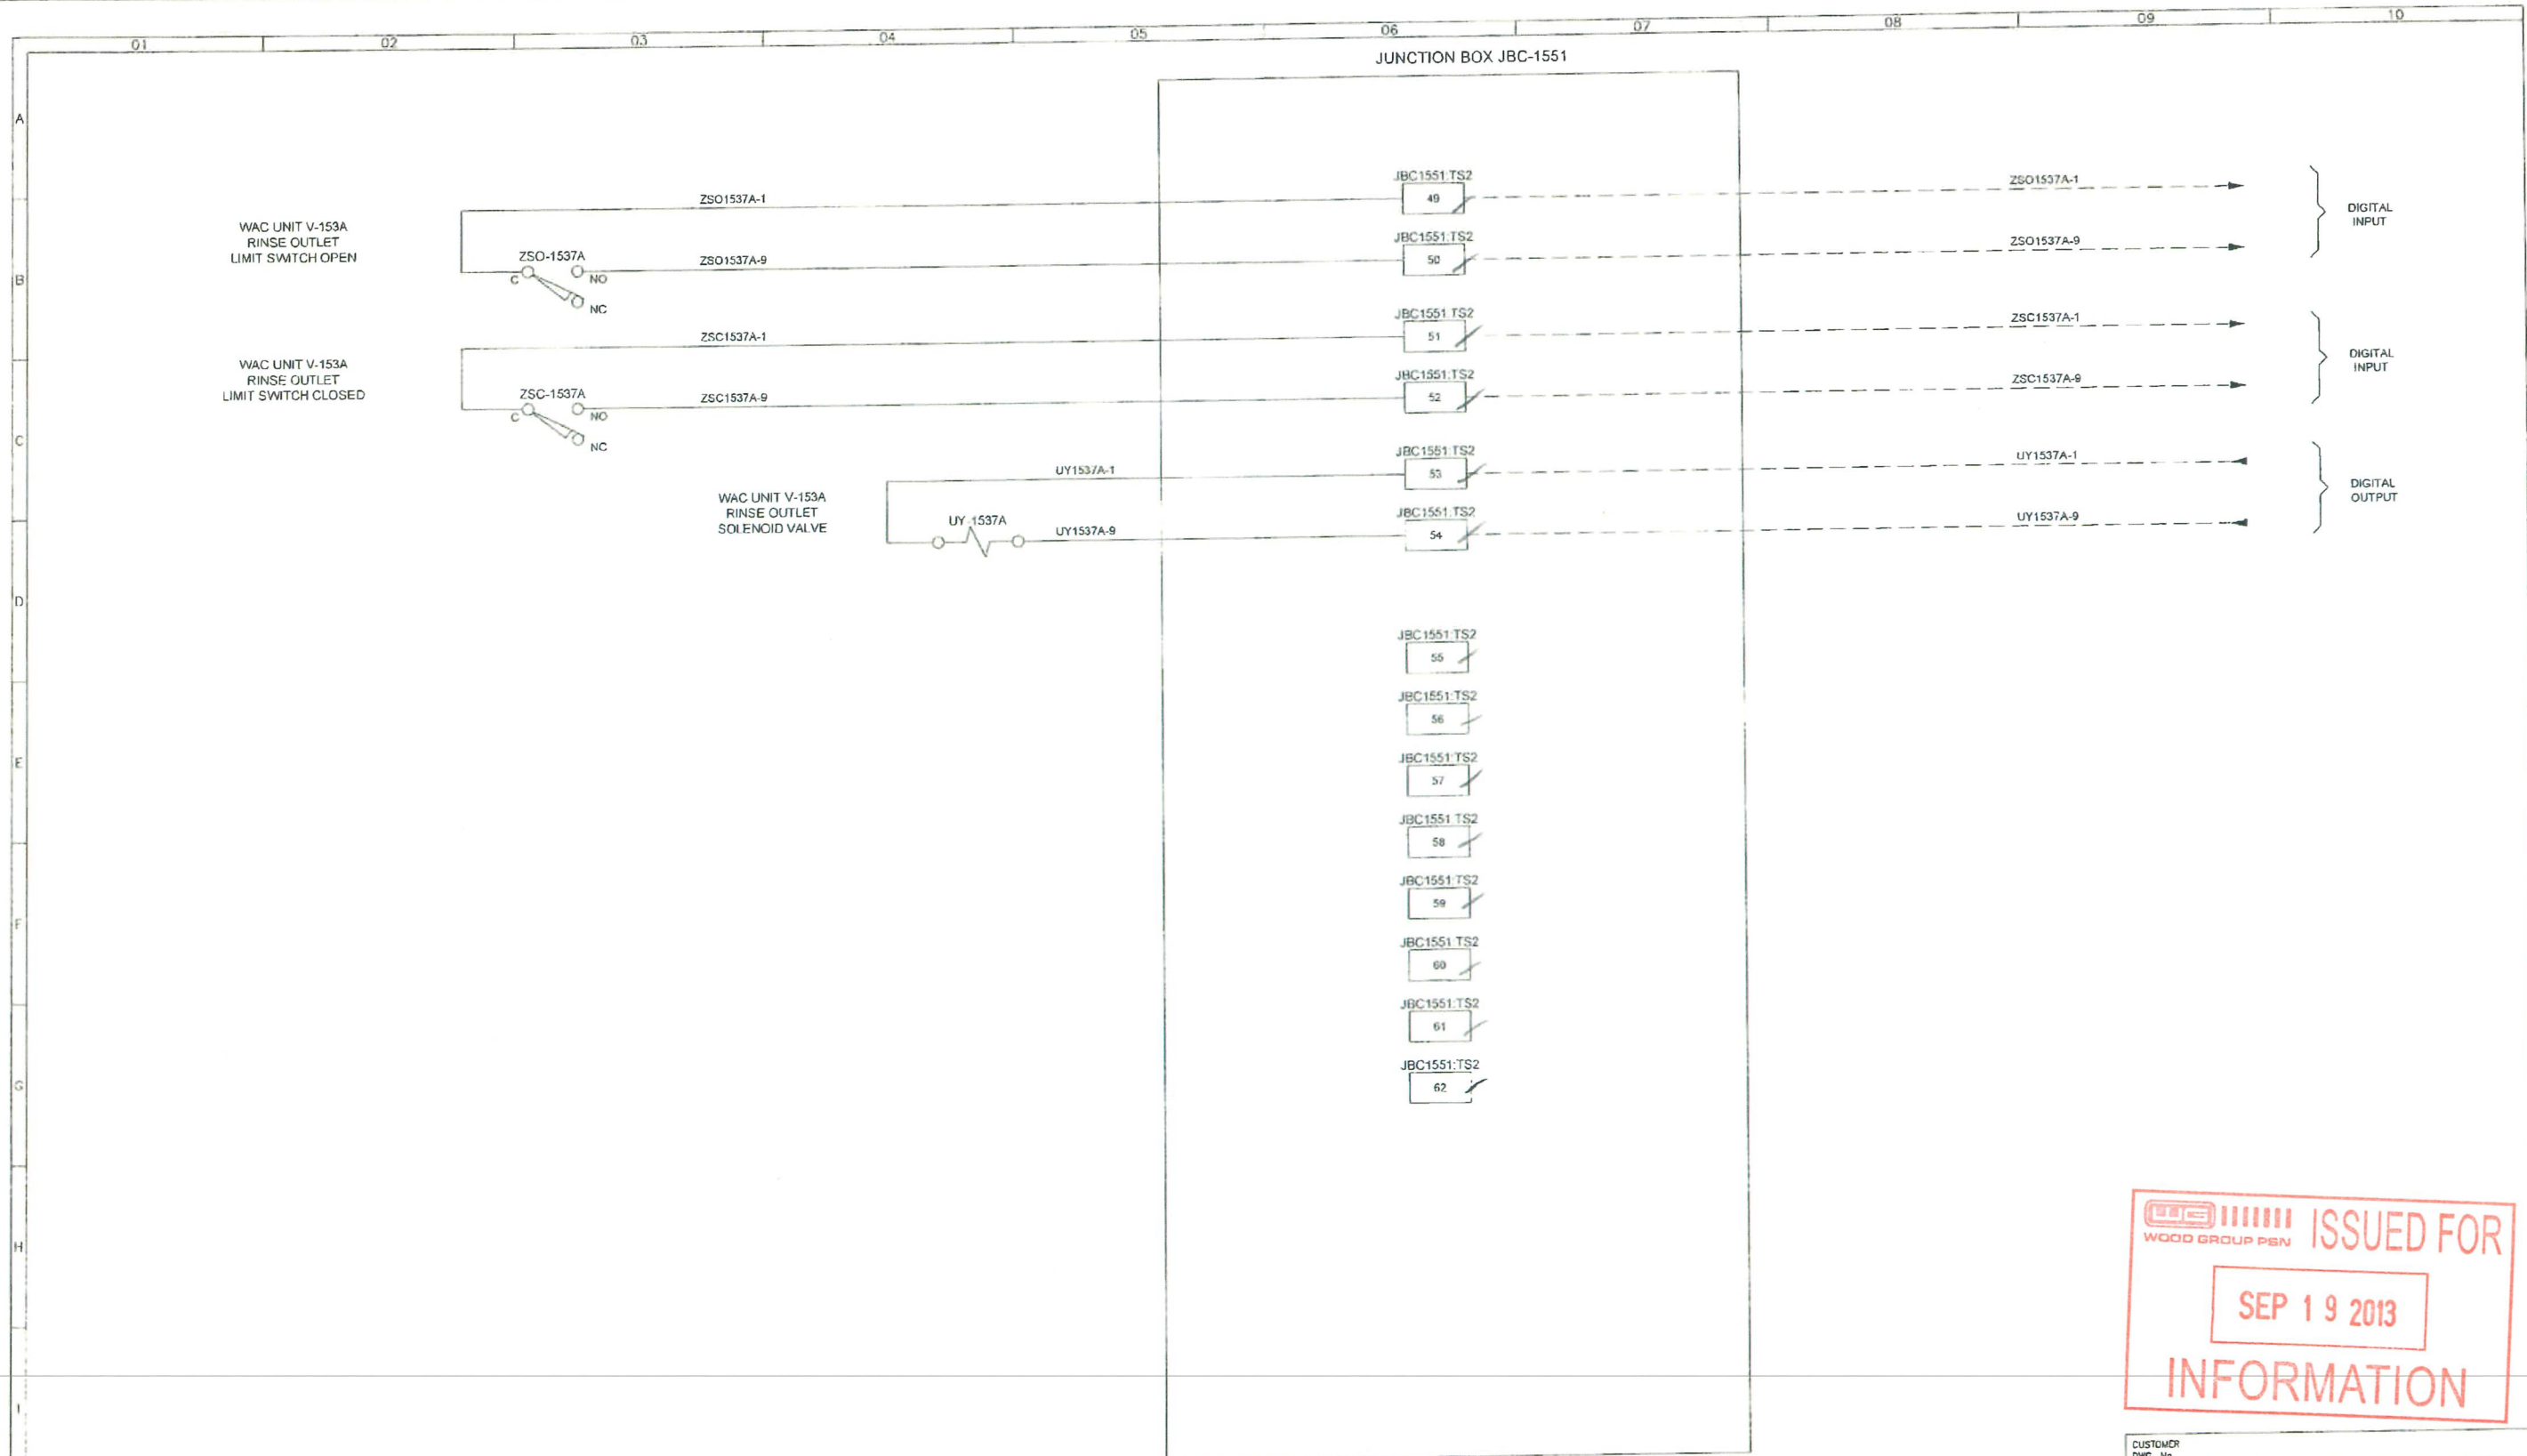

ISSUED FOR
SEP 19 2013
INFORMATION

THIS DRAWING AND ALL INFORMATION AND KNOWLEDGE CONTAINED OR REFERRED HEREIN ARE THE CONFIDENTIAL AND PROPRIETARY PROPERTY OF ANDERSON WATER SYSTEMS, INC. ("AWS") AND AS SUCH ARE INSTRUMENTS OF SERVICE FOR USE SOLELY WITH RESPECT TO THIS PROJECT. THESE INSTRUMENTS OF SERVICE SHALL NOT BE REPRODUCED, TRANSMITTED, DISCLOSED OR USED OTHERWISE IN WHOLE OR IN PART WITHOUT THE WRITTEN AGREEMENT BY AWS AND MUST BE RETURNED OR DESTROYED UPON REQUEST.

REV	REVISION DESCRIPTION	DRWN	CHKD	APP	DATE
A	ORIGINAL ISSUE	SS	JW	DP	NOV 12
B	CUSTOMER COMMENTS ADDED	SS	JW	DP	JAN 13
C	REVISED PER CUSTOMER COMMENTS	SS	JW	DP	MAY 13
D	AS BUILT	SS	JW	DP	JUN 13


REV	REVISION DESCRIPTION	DRWN	CHKD	APP	DATE

PROJECT INFORMATION
 ZARGON LITTLE BOW ASP FACILITY
 LSD 16-31-14-18 W4M
 ALBERTA, CANADA
 CONTRACT NUMBER
 120128

ANDERSON WATER SYSTEMS
 44 Head St., Dundas, Ontario
 L9H 3H3 Canada
 Phone: +1 (905) 627-9233
 www.AWSL.com

BY	DATE
SS	NOV 12
JW	NOV 12
DP	NOV 12
SCALE	
TOTAL NUMBER OF LOOP PAGES: 17	

CUSTOMER Dwg. No.	
LOOP DIAGRAM	
WEAK ACID CATION	
UNIT V-153A	
SIZE	B
DWG. NO.	120128-0919-1-LOOP-006
REV.	D

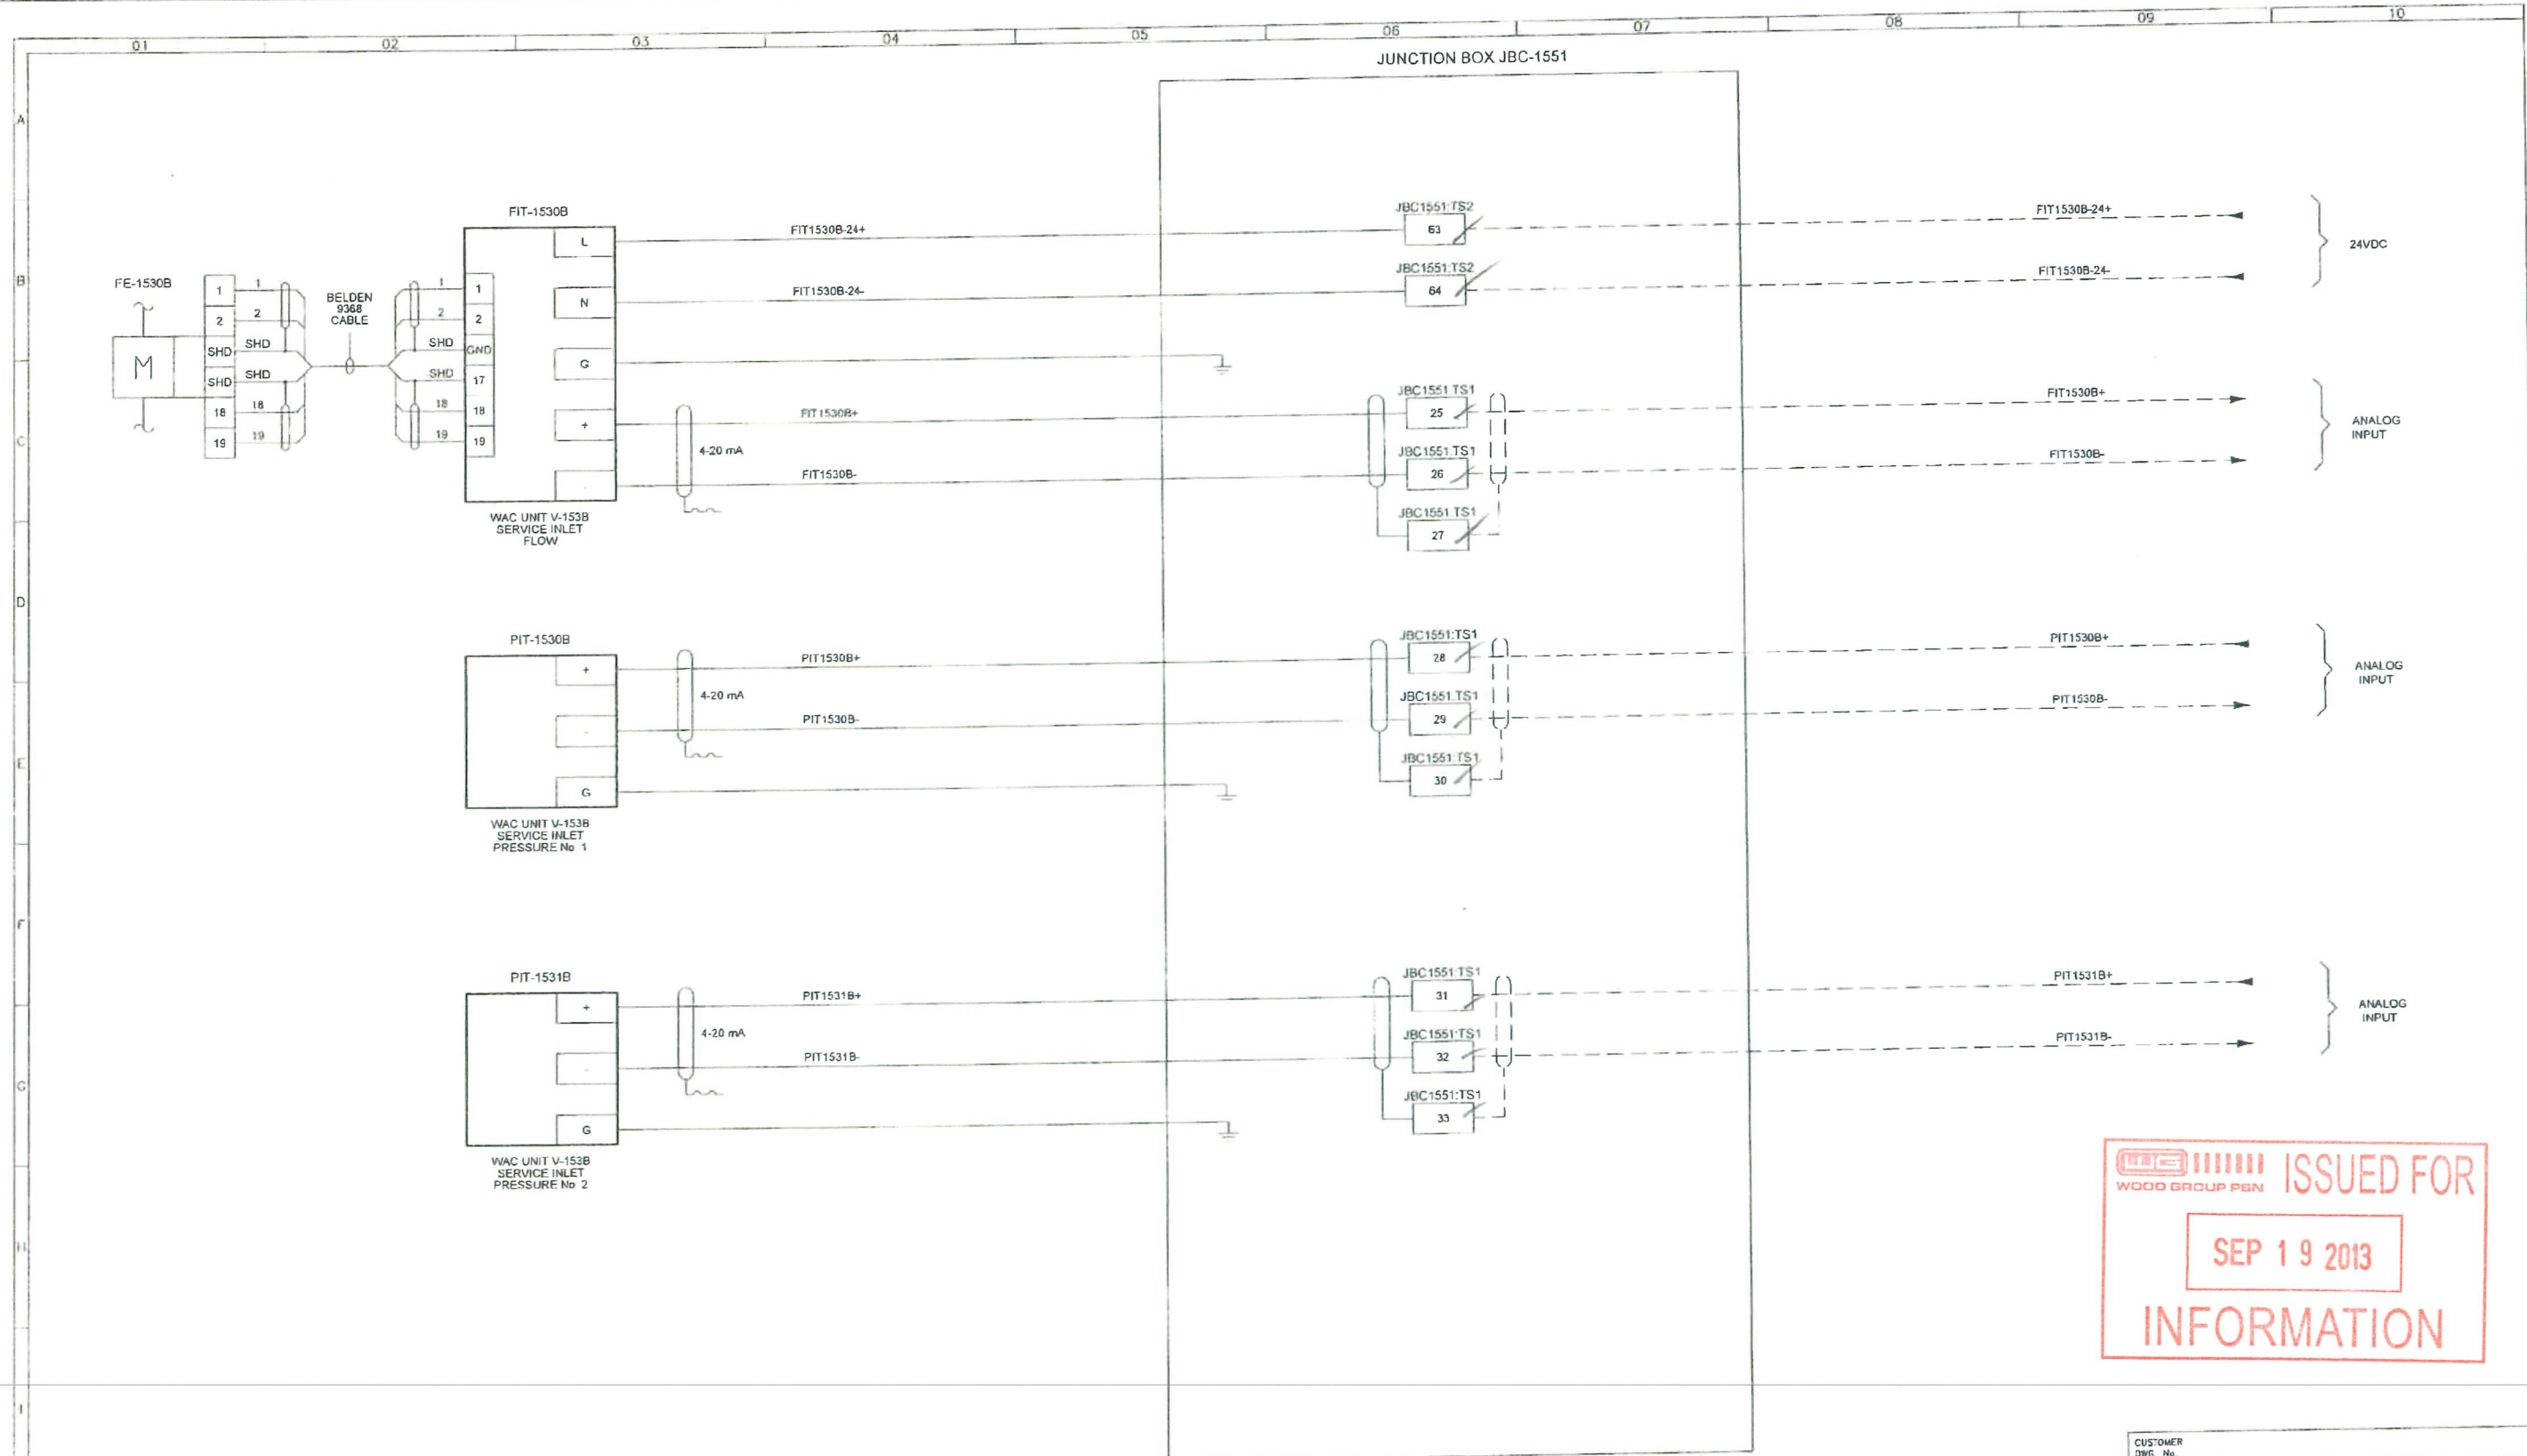

ISSUED FOR
SEP 19 2013
INFORMATION

THIS DRAWING AND ALL INFORMATION AND KNOWLEDGE CONTAINED OR REFERRED HEREIN ARE THE CONFIDENTIAL AND PROPRIETARY PROPERTY OF ANDERSON WATER SYSTEMS, INC. ("AWS") AND AS SUCH ARE INSTRUMENTS OF SERVICE FOR USE SOLELY WITH RESPECT TO THIS PROJECT. THESE INSTRUMENTS OF SERVICE SHALL NOT BE REPRODUCED, TRANSMITTED, DISCLOSED OR USED OTHERWISE IN WHOLE OR IN PART WITHOUT THE WRITTEN AGREEMENT BY AWS AND MUST BE RETURNED OR DESTROYED UPON REQUEST.

REV	REVISION DESCRIPTION	DRWN	CHKD	APP	DATE
A	ORIGINAL ISSUE	SS	JW	DP	NOV. 12
B	CUSTOMER COMMENTS ADDED	SS	JW	DP	JAN. 13
C	REVISED PER CUSTOMER COMMENTS	SS	JW	DP	MAY 13
D	AS BUILT	SS	JW	DP	JUN 13


REV	REVISION DESCRIPTION	DRWN	CHKD	APP	DATE

PROJECT INFORMATION
ZARGON LITTLE BOW ASP FACILITY
LSD 16-31-14-18 W4M
ALBERTA, CANADA
CONTRACT NUMBER
120128

ANDERSON WATER SYSTEMS
44 Head St., Dundas, Ontario
L9H 3H3 Canada
Phone: +1 (905) 627-9233
www.AWSL.com

BY	DATE
SS	NOV. 12
JW	NOV. 12
DP	NOV. 12
REV.	
SCALE	
TOTAL NUMBER OF LOOP PACKS	17

CUSTOMER DWG. No.	LOOP DIAGRAM
	WEAK ACID CATION
	UNIT V-153B
SIZE	
DWG. NO.	120128-0919-1-LOOP-007
REV.	D

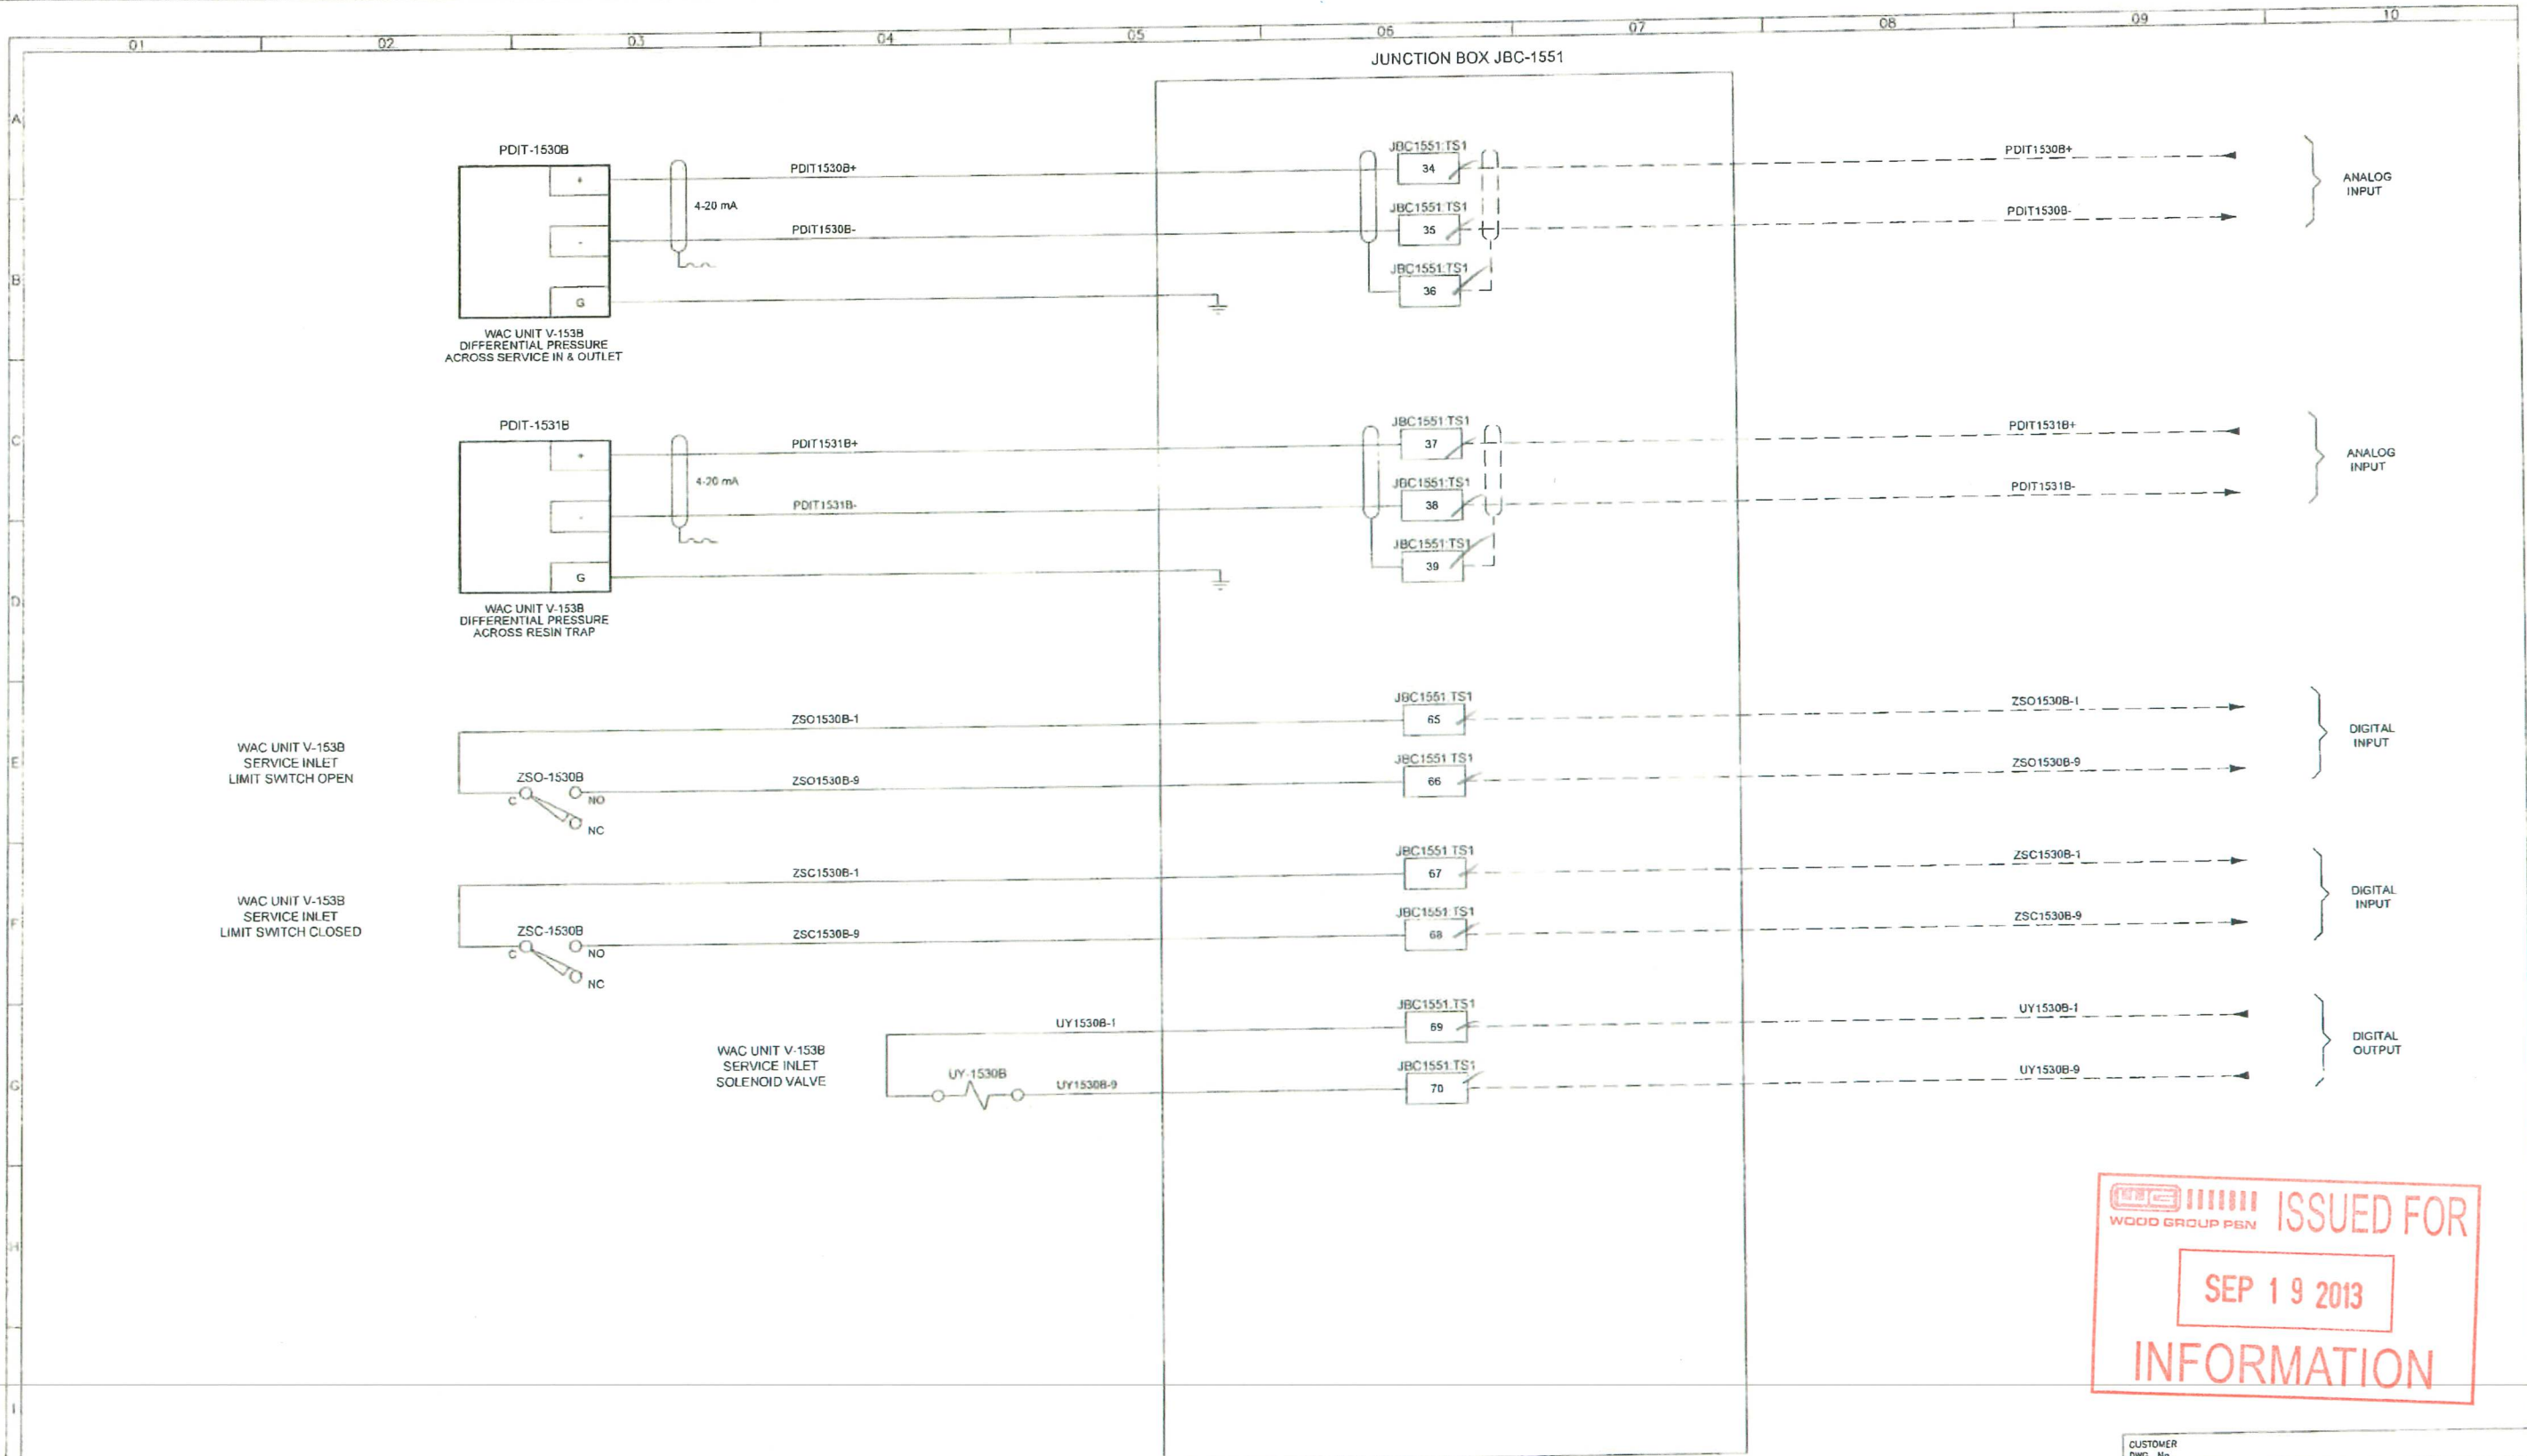

ISSUED FOR

SEP 19 2013

INFORMATION

THIS DRAWING AND ALL INFORMATION AND KNOWLEDGE CONTAINED OR REFERRED HEREIN ARE THE CONFIDENTIAL AND PROPRIETARY PROPERTY OF ANDERSON WATER SYSTEMS, INC. ("AWS") AND AS SUCH ARE INSTRUMENTS OF SERVICE FOR USE SOLELY WITH RESPECT TO THIS PROJECT. THESE INSTRUMENTS OF SERVICE SHALL NOT BE REPRODUCED, TRANSMITTED, DISCLOSED OR USED OTHERWISE IN WHOLE OR IN PART WITHOUT THE WRITTEN AGREEMENT BY AWS AND MUST BE RETURNED OR DESTROYED UPON REQUEST.

REV	REVISION DESCRIPTION	DRWN	CHKD	APP	DATE
A	ORIGINAL ISSUE	SS	JW	DP	NOV. 12
B	CUSTOMER COMMENTS ADDED	SS	JW	DP	JAN. 13
C	REVISED PER CUSTOMER COMMENTS	SS	JW	DP	MAY 13
D	AS BUILT	SS	JW	DP	JUN 13

REV	REVISION DESCRIPTION	DRWN	CHKD	APP	DATE

PROJECT INFORMATION

ZARGON LITTLE BOW ASP FACILITY

LSD 16-31-14-18 W4M

ALBERTA, CANADA

CONTRACT NUMBER 120128

ANDERSON WATER SYSTEMS

44 Head St., Dundas, Ontario L9H 3H3 Canada


Phone: +1 (905) 627-9233

www.AWSL.com

BY	DATE
SS	NOV. 12
JW	NOV. 12
DP	NOV. 12

CUSTOMER DWG. No.		LOOP DIAGRAM	
		WEAK ACID CATION	
		UNIT V-153B	
SIZE	B	120128-0919-1-LOOP-008	REV D
SCALE			
TOTAL NUMBER OF LOOP PAGES	17		

ISSUED FOR
SEP 19 2013
INFORMATION

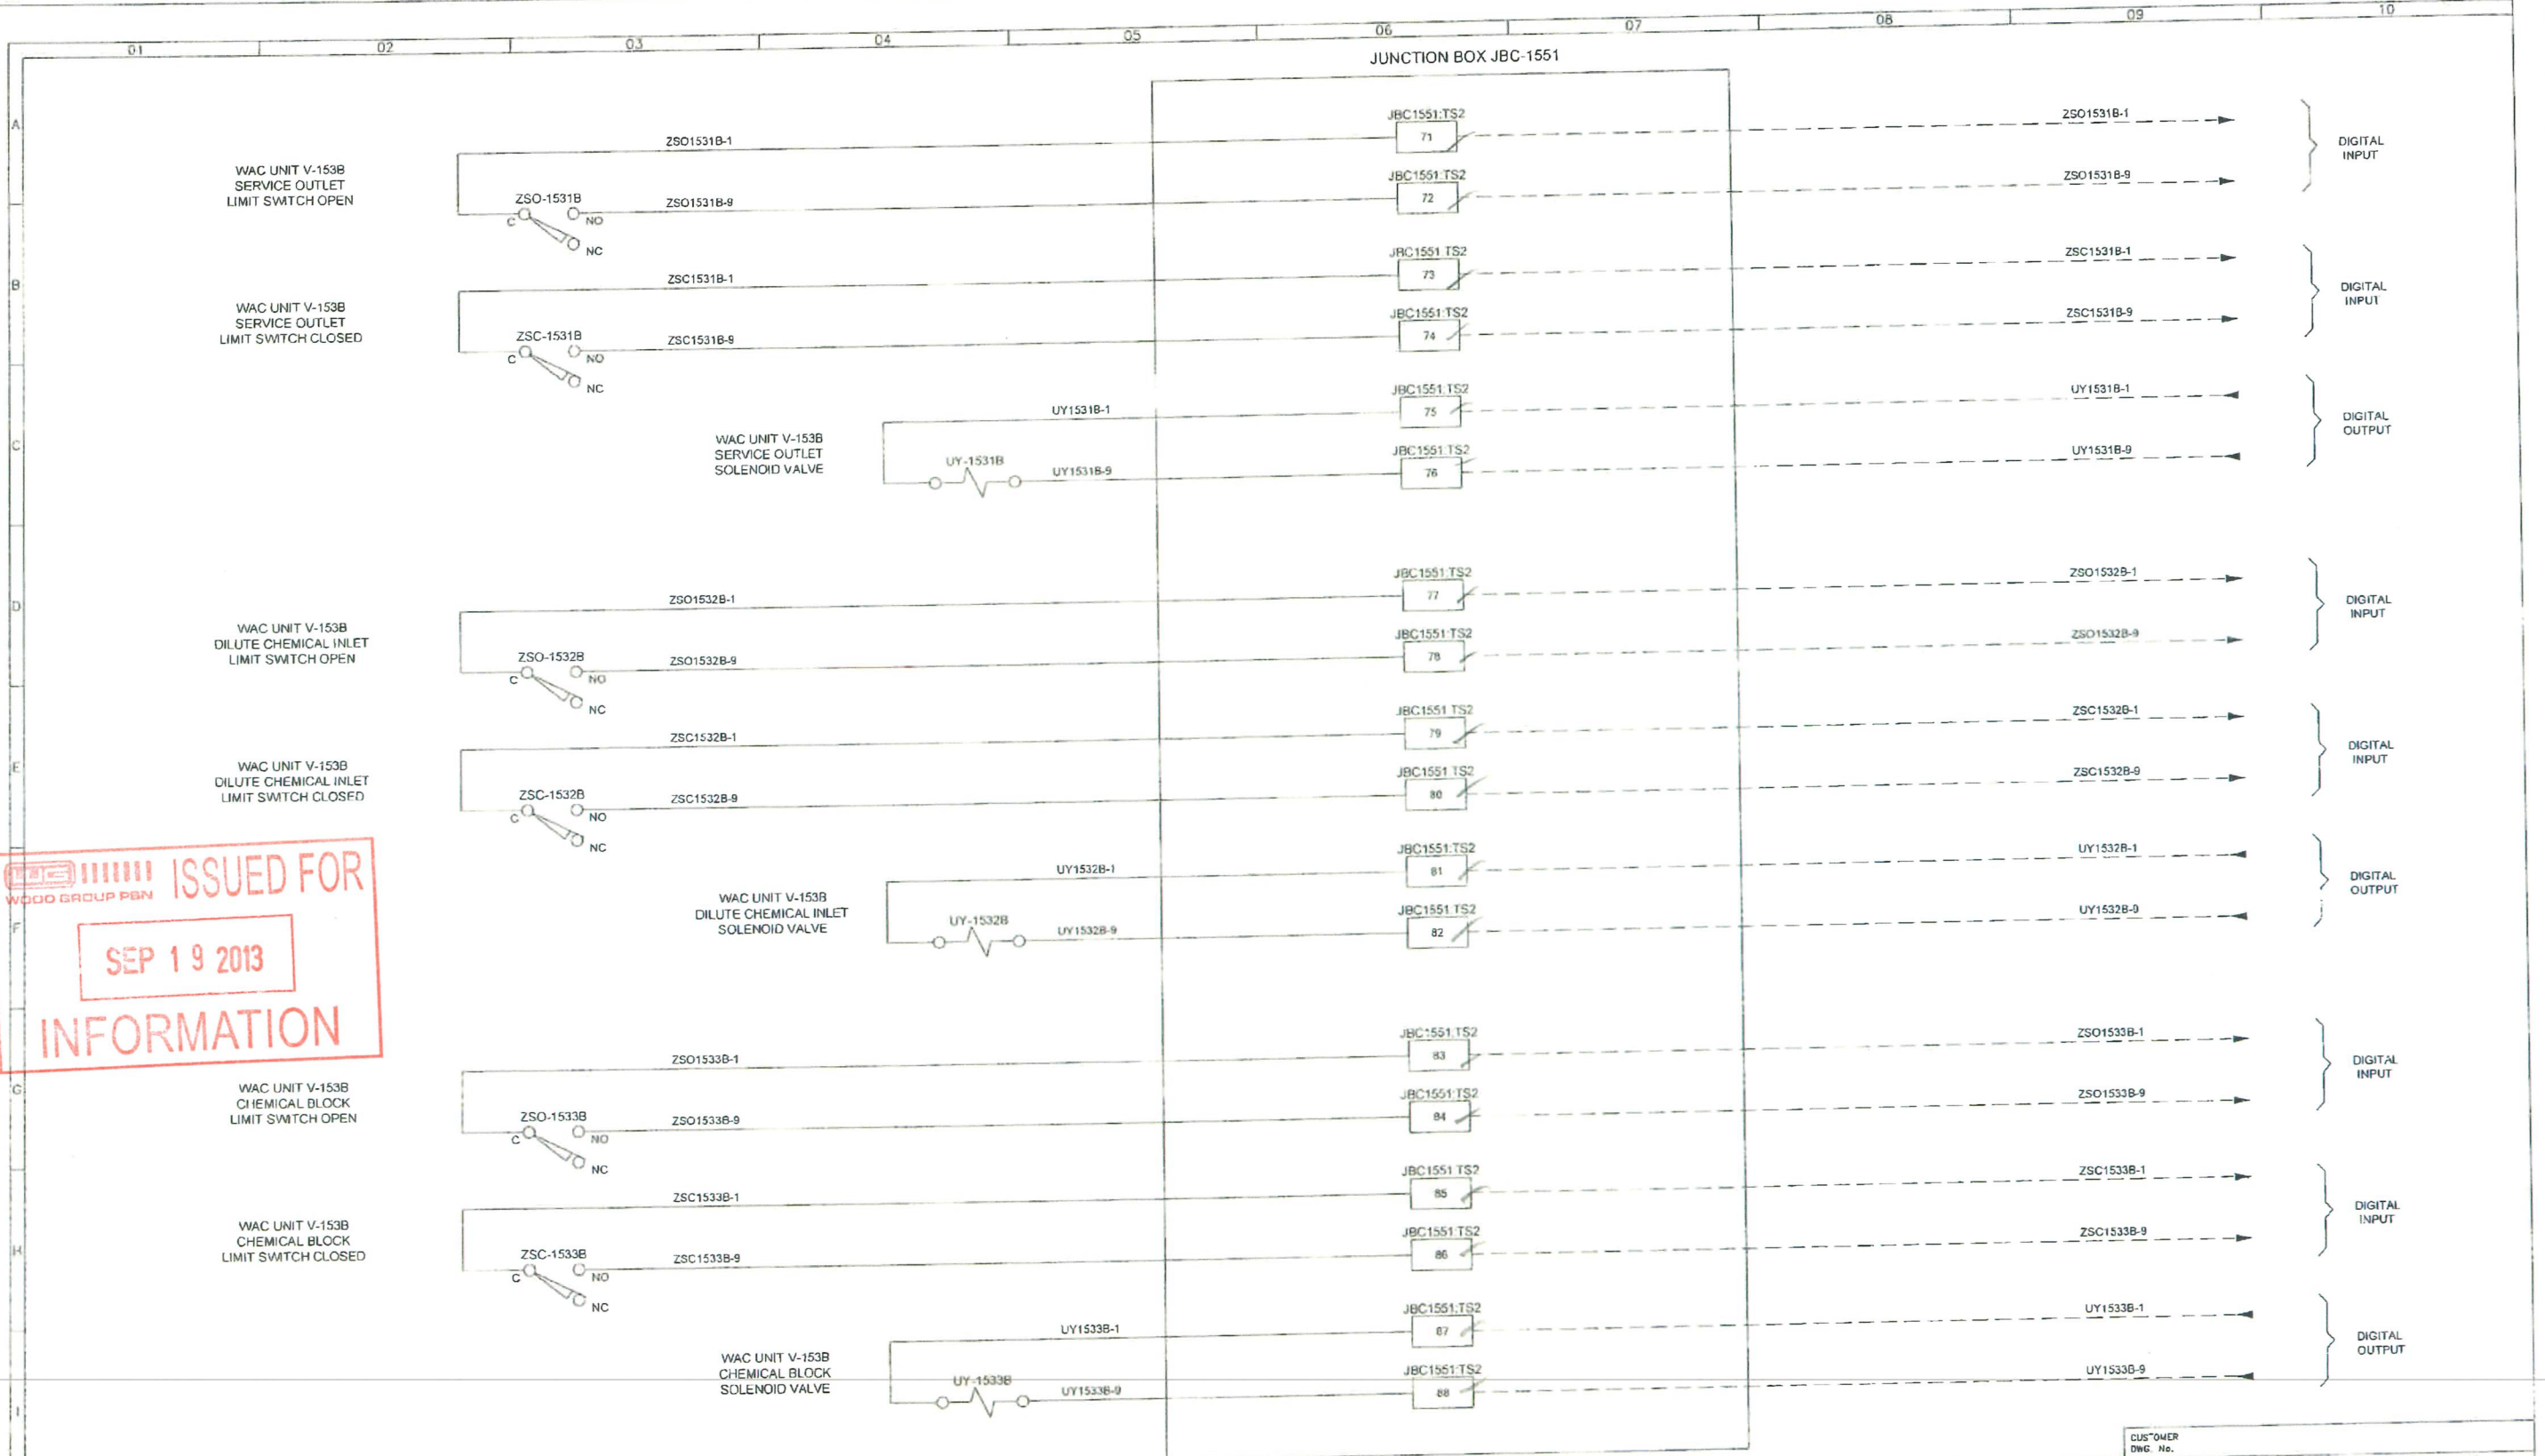

THIS DRAWING AND ALL INFORMATION AND KNOWLEDGE CONTAINED OR REFERRED HEREIN ARE THE CONFIDENTIAL AND PROPRIETARY PROPERTY OF ANDERSON WATER SYSTEMS, INC. (AWS) AND AS SUCH ARE INSTRUMENTS OF SERVICE FOR USE SOLELY WITH RESPECT TO THIS PROJECT. THESE INSTRUMENTS OF SERVICE SHALL NOT BE REPRODUCED, TRANSMITTED, DISCLOSED OR USED OTHERWISE IN WHOLE OR IN PART WITHOUT THE WRITTEN AGREEMENT BY AWS AND MUST BE RETURNED OR DESTROYED UPON REQUEST.

REV	REVISION DESCRIPTION	DRWN	CHKD	APP	DATE
A	ORIGINAL ISSUE	SS	JW	DP	NOV. 12
B	CUSTOMER COMMENTS ADDED	SS	JW	DP	JAN. 13
C	REVISED PER CUSTOMER COMMENTS	SS	JW	DP	MAY .13
D	AS BUILT	SS	JW	DP	JUN .13


REV	REVISION DESCRIPTION	DRWN	CHKD	APP	DATE

PROJECT INFORMATION
ZARCON JITTLE BOW ASP FACILITY
LSD 16-31-14-18 W4M
ALBERTA, CANADA
CONTRACT NUMBER
120128

ANDERSON WATER SYSTEMS
44 Head St., Dundas, Ontario
L9H 3H3 Canada
Phone: +1 (905) 627-9233
www.AWSL.com

BY	DATE
SS	NOV. 12
JW	NOV. 12
DP	NOV. 12

CUSTOMER Dwg. No.	LOOP DIAGRAM
	WEAK ACID CATION
	UNIT V-153B
SCALE	SIZE
TOTAL NUMBER OF LISTS: 17	B
DWG. NO.	120128-0919-1-LOOP-009
REV.	D

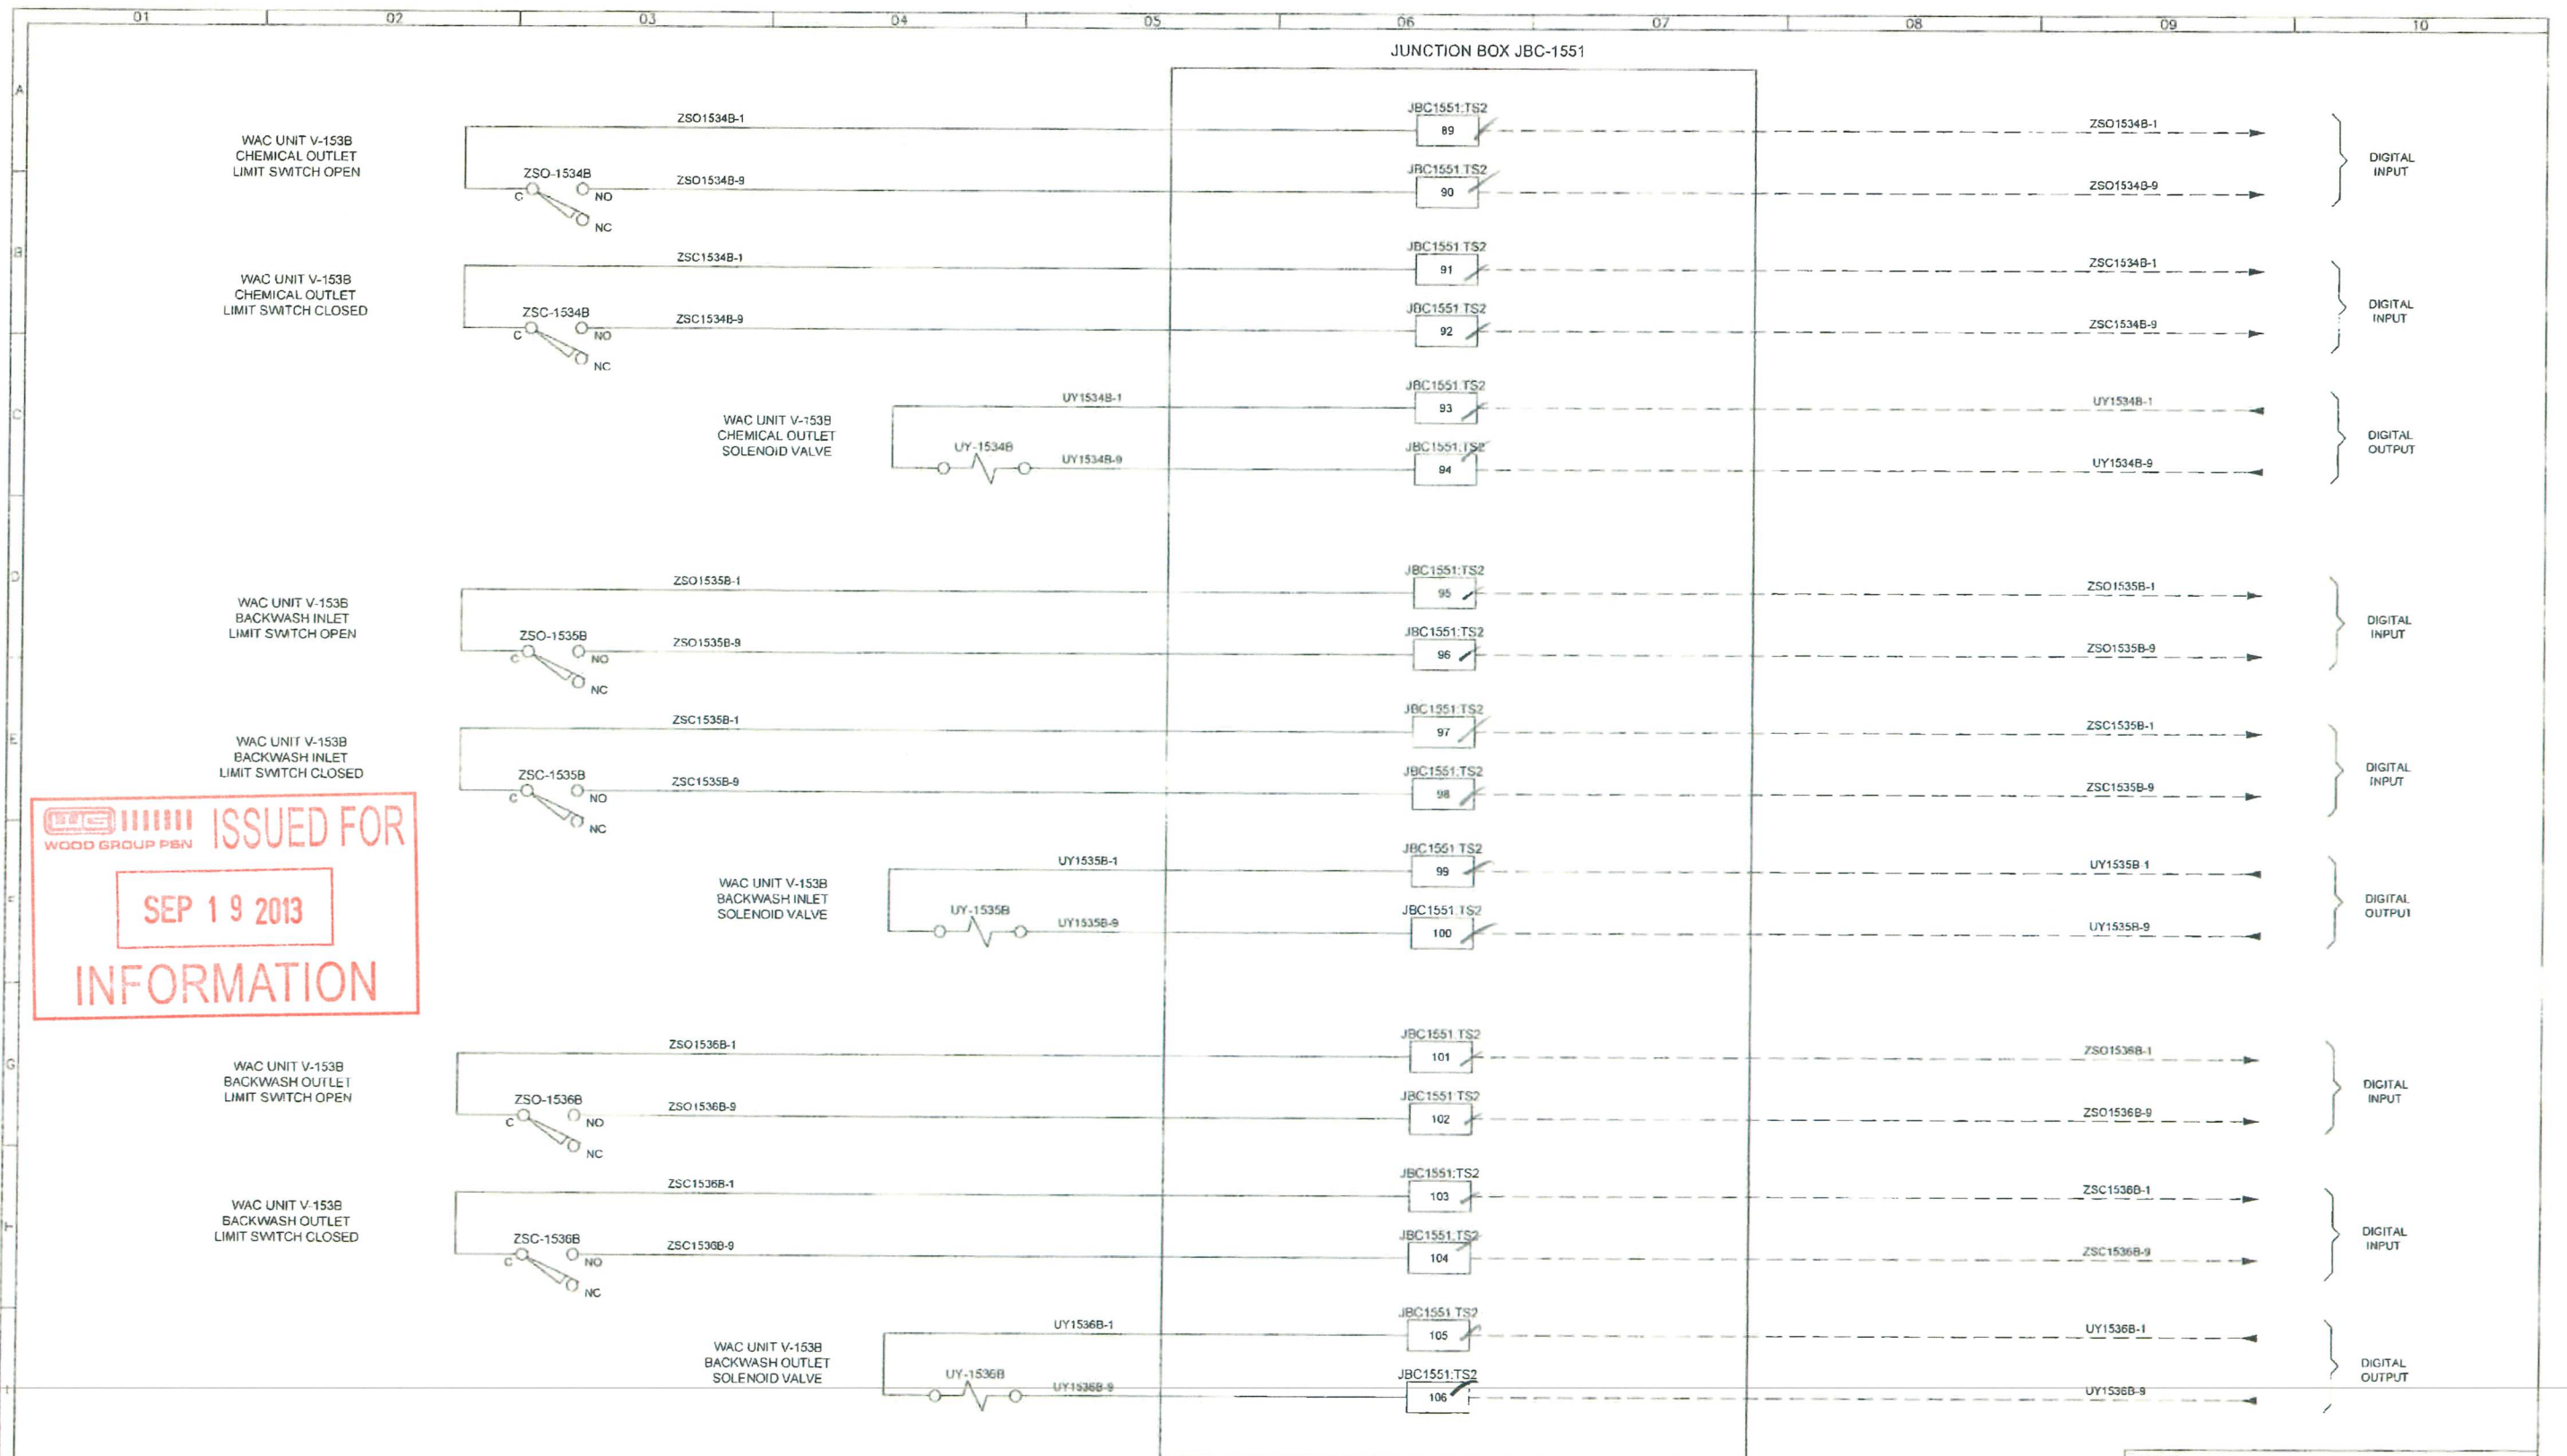

ISSUED FOR
SEP 19 2013
INFORMATION

THIS DRAWING AND ALL INFORMATION AND KNOWLEDGE CONTAINED OR REFERRED HEREIN ARE THE CONFIDENTIAL AND PROPRIETARY PROPERTY OF ANDERSON WATER SYSTEMS, INC. ("AWS") AND AS SUCH ARE INSTRUMENTS OF SERVICE FOR USE SOLELY WITH RESPECT TO THIS PROJECT. THESE INSTRUMENTS OF SERVICE SHALL NOT BE REPRODUCED, TRANSMITTED, DISCLOSED OR USED OTHERWISE IN WHOLE OR IN PART WITHOUT THE WRITTEN AGREEMENT BY AWS AND MUST BE RETURNED OR DESTROYED UPON REQUEST.

REV	REVISION DESCRIPTION	DRWN	CHKD	APP	DATE
A	ORIGINAL ISSUE	SS	JW	DP	NOV. 12
B	CUSTOMER COMMENTS ADDED	SS	JW	DP	JAN. 13
C	REVISED PER CUSTOMER COMMENTS	SS	JW	DP	MAY 13
D	AS BUILT	SS	JW	DP	JUN 13


REV	REVISION DESCRIPTION	DRWN	CHKD	APP	DATE

PROJECT INFORMATION
ZARGON LITTLE BOW ASP FACILITY
LSD 16-31-14-18 W4M
ALBERTA, CANADA
CONTRACT NUMBER
120128

ANDERSON WATER SYSTEMS
44 Head St., Dundas, Ontario
L9H 3H3 Canada
Phone: +1 (905) 627-9233
www.AWSL.com

BY	DATE
DRWN SS	NOV. 12
CHKD JW	NOV. 12
APP DP	NOV. 12
REF.	
SCALE	
TOTAL NUMBER OF LOOP PAGES:	17

CUSTOMER DWG. No.	
LOOP DIAGRAM	
WEAK ACID CATION	
UNIT V-153B	
SIZE	B
DWG. NO.	120128-0919-1-LOOP-010
REV.	D

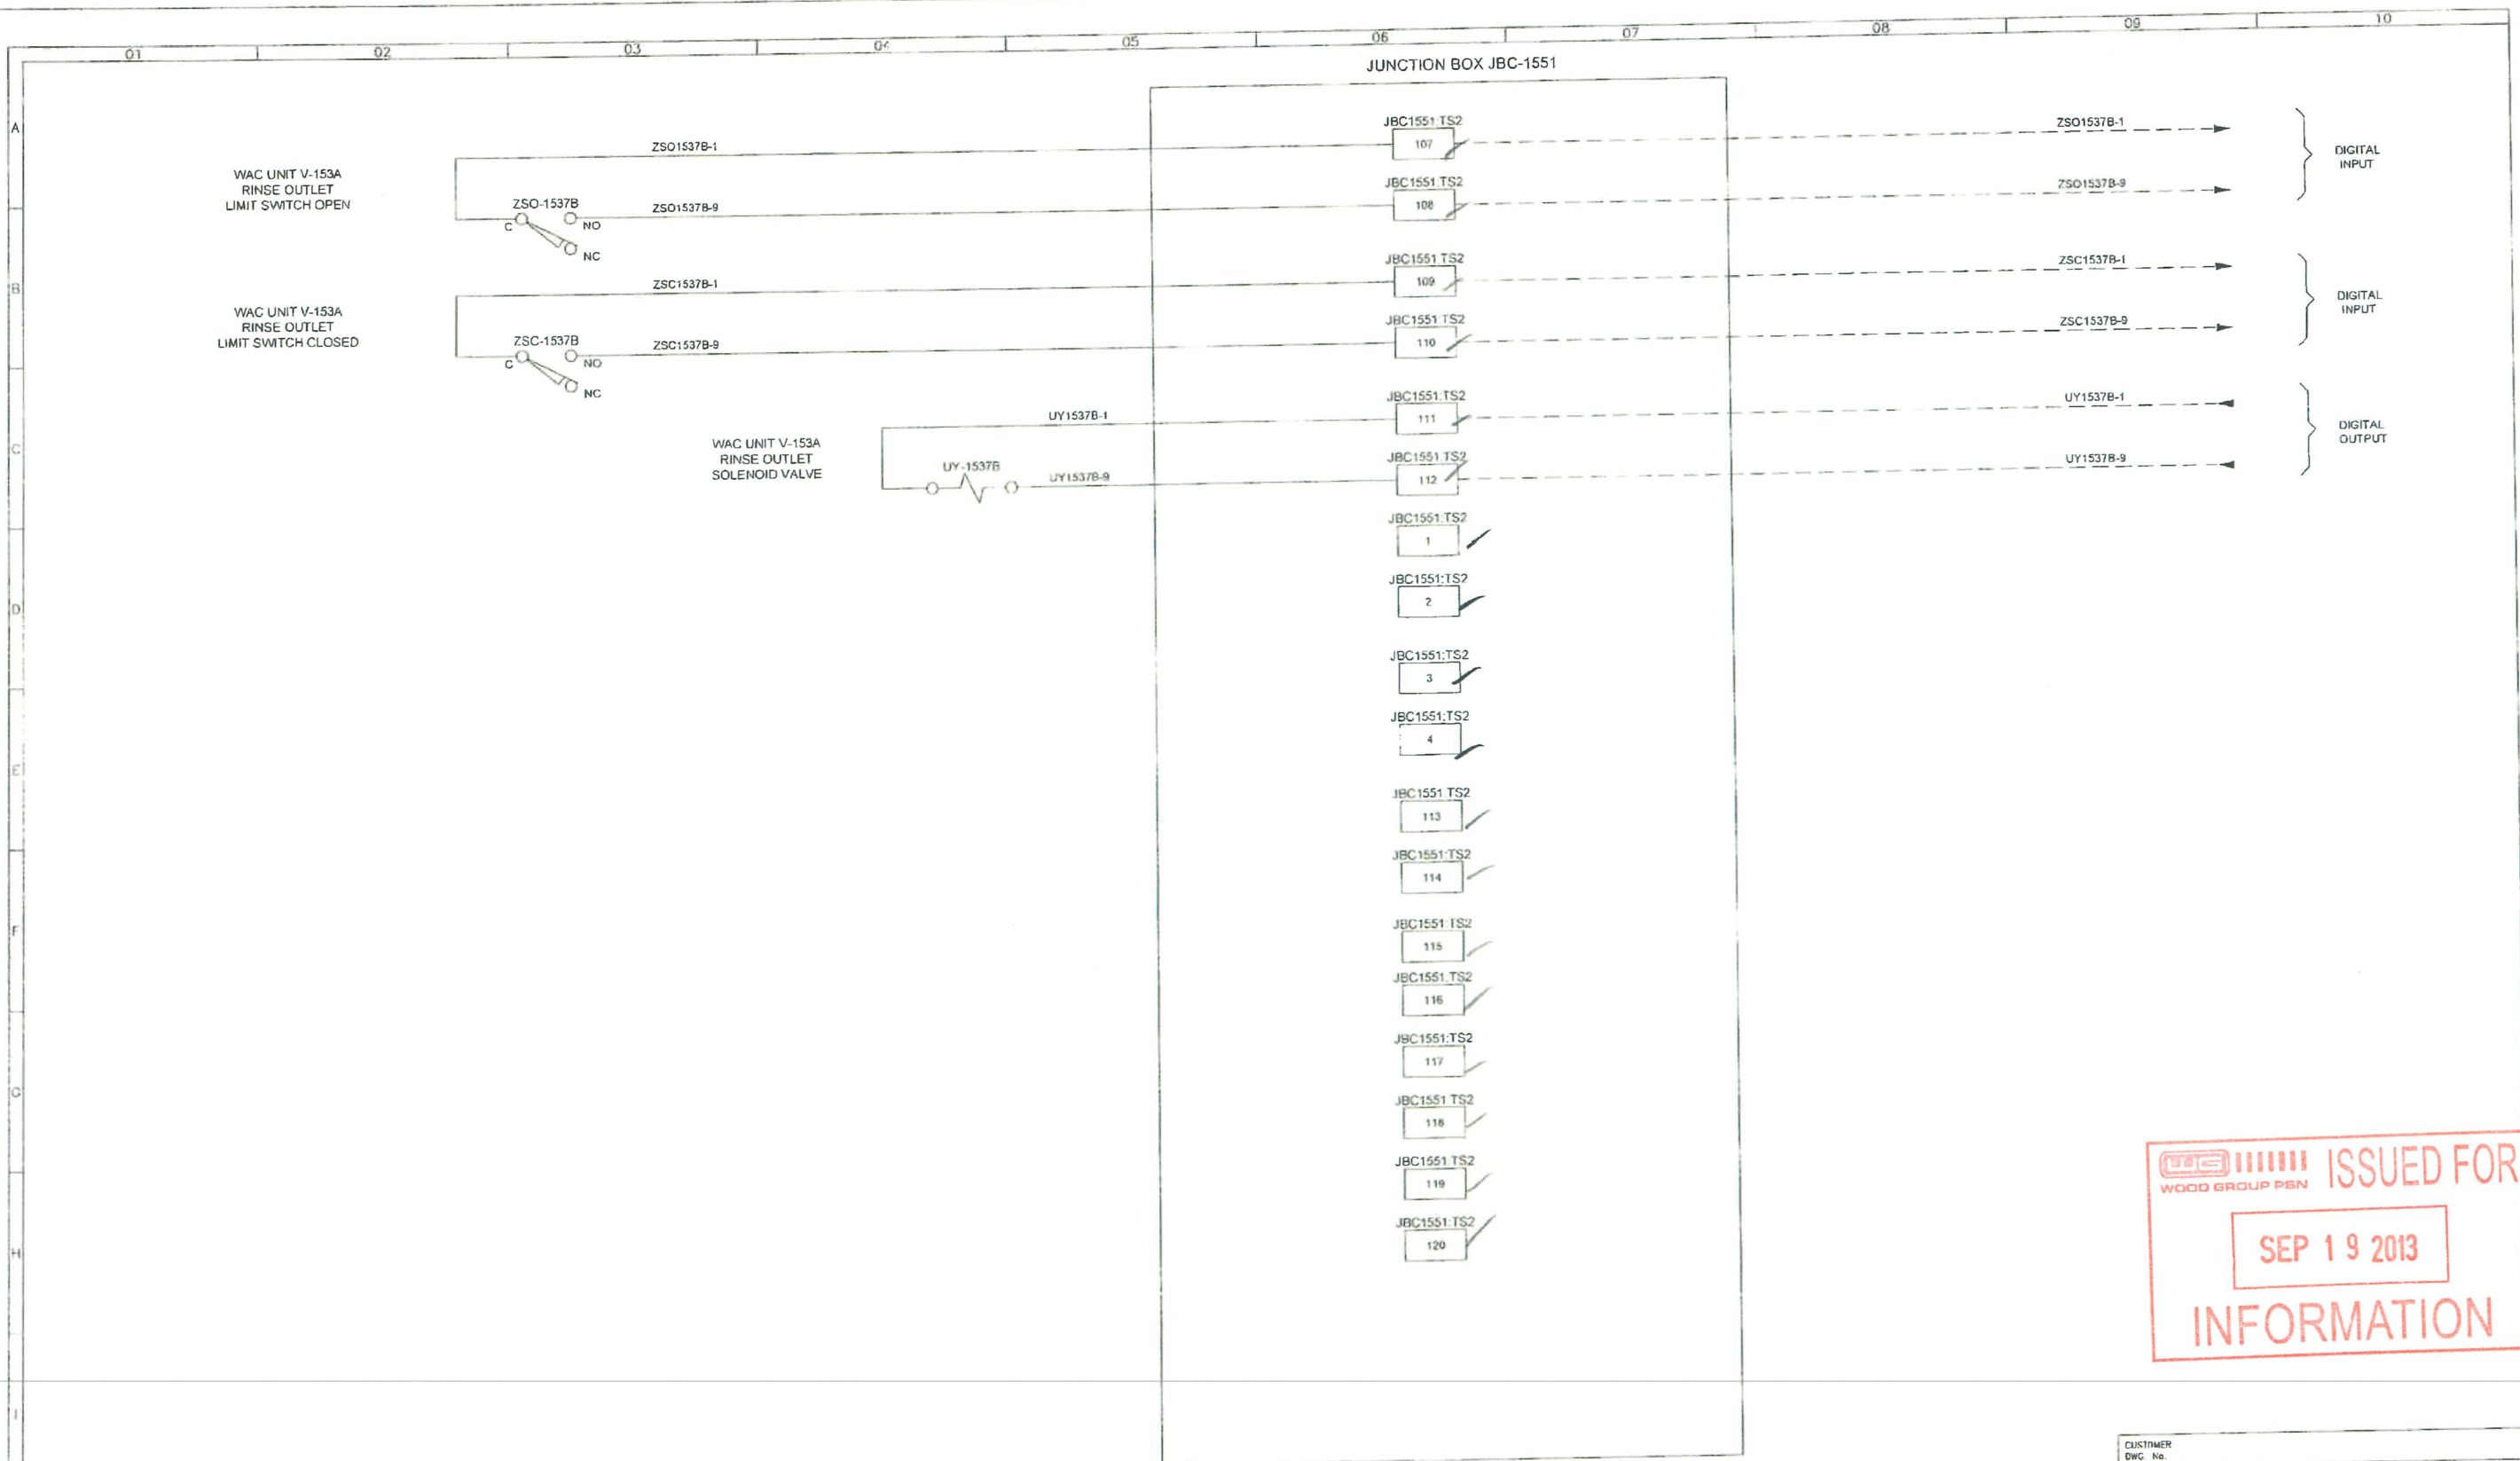

ISSUED FOR
SEP 19 2013
INFORMATION

THIS DRAWING AND ALL INFORMATION AND KNOWLEDGE CONTAINED OR REFERRED HEREIN ARE THE CONFIDENTIAL AND PROPRIETARY PROPERTY OF ANDERSON WATER SYSTEMS, INC. ("AWS") AND AS SUCH ARE INSTRUMENTS OF SERVICE FOR USE SOLELY WITH RESPECT TO THIS PROJECT. THESE INSTRUMENTS OF SERVICE SHALL NOT BE REPRODUCED, TRANSMITTED, DISCLOSED OR USED OTHERWISE IN WHOLE OR IN PART WITHOUT THE WRITTEN AGREEMENT BY AWS AND MUST BE RETURNED OR DESTROYED UPON REQUEST.

REV	REVISION DESCRIPTION	DRWN	CHKD	APP	DATE
A	ORIGINAL ISSUE	SS	JW	DP	NOV. 12
B	CUSTOMER COMMENTS ADDED	SS	JW	DP	JAN. 13
C	REVISED PER CUSTOMER COMMENTS	SS	JW	DP	MAY 13
D	AS BUILT	SS	JW	DP	JUN .13


REV	REVISION DESCRIPTION	DRWN	CHKD	APP	DATE

PROJECT INFORMATION
 ZARGON LITTLE BOW ASP FACILITY
 LSD 16-31-14-18 W4M
 ALBERTA, CANADA
 CONTRACT NUMBER
 120128

ANDERSON WATER SYSTEMS
 44 Head St., Dundas, Ontario
 L9H 3H3 Canada
 Phone: +1 (905) 627-9233
 www.AWSL.com

BY	DATE
SS	NOV 12
JW	NOV. 12
DP	NOV. 12

CUSTOMER	LOOP DIAGRAM
DWG. No.	WEAK ACID CATION
	UNIT V-153B
SCALE	
TOTAL NUMBER OF LOOP PAGES: 17	
SIZE	
DWG. NO.	120128-0919-1-LOOP-011
REV.	D

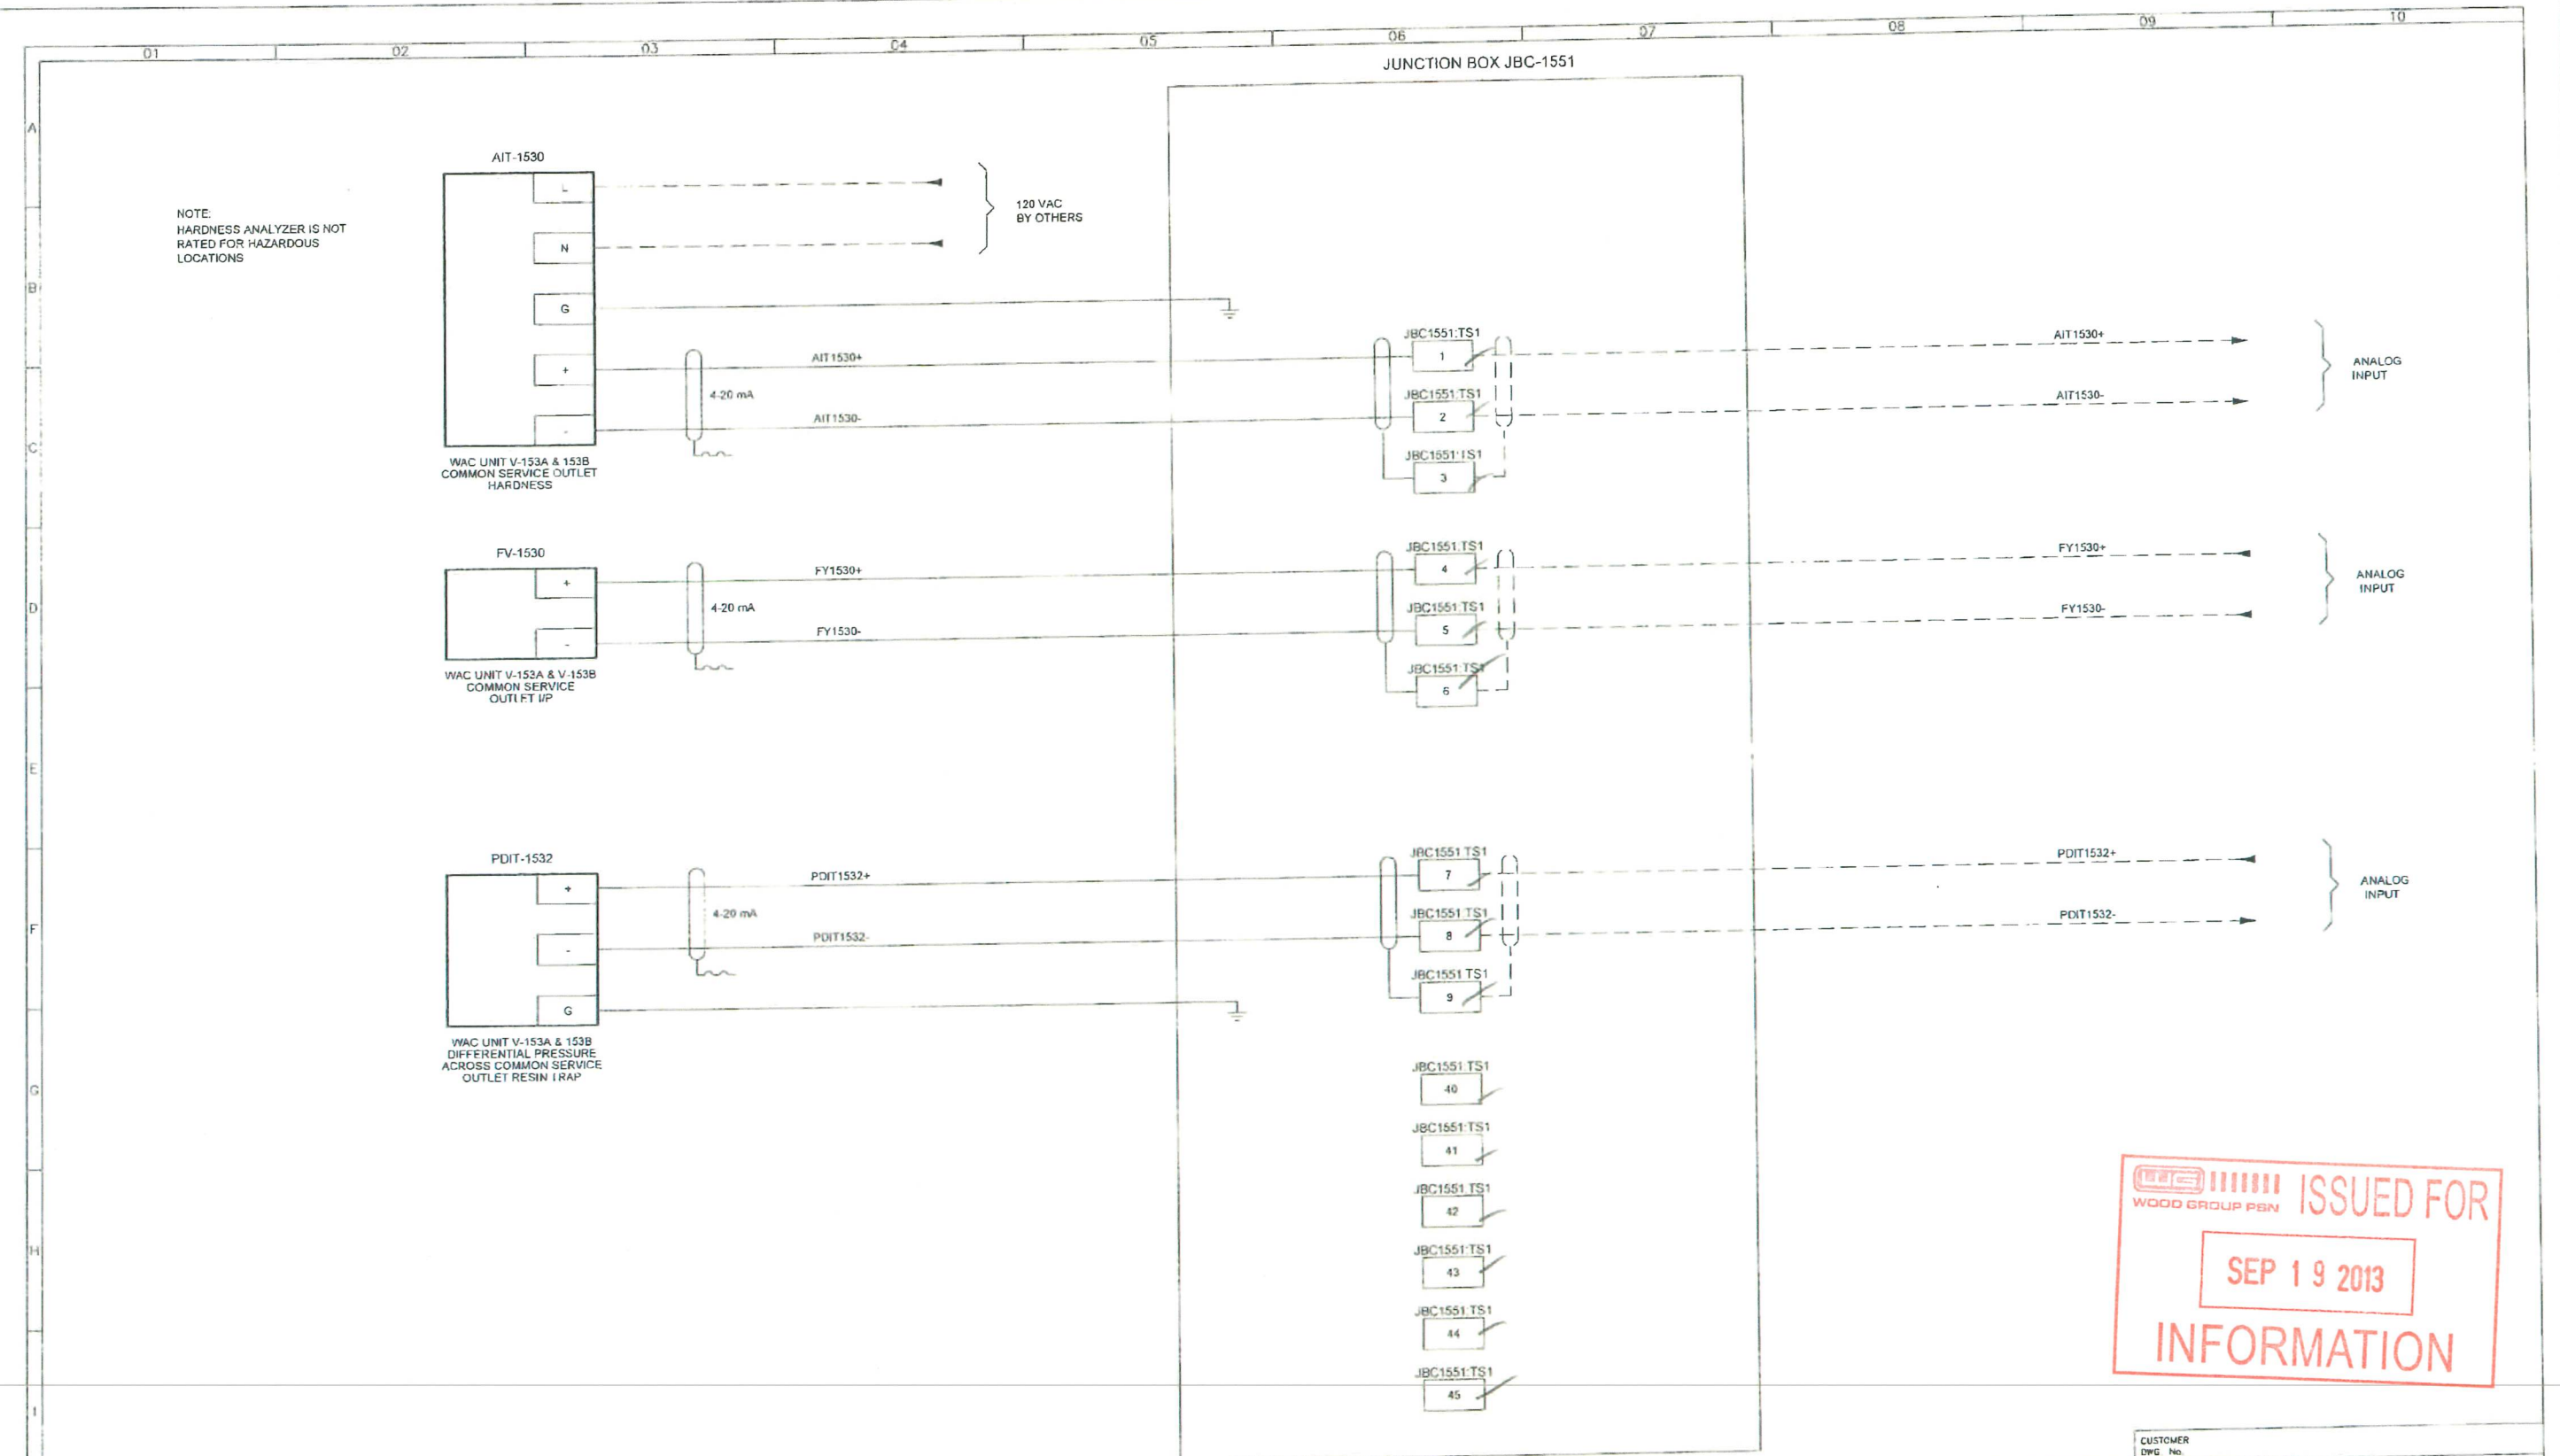

ISSUED FOR
SEP 19 2013
INFORMATION

THIS DRAWING AND ALL INFORMATION AND KNOWLEDGE CONTAINED OR REFERRED HEREIN ARE THE CONFIDENTIAL AND PROPRIETARY PROPERTY OF ANDERSON WATER SYSTEMS, INC. ("AWS") AND AS SUCH ARE INSTRUMENTS OF SERVICE FOR USE SOLELY WITH RESPECT TO THIS PROJECT. THESE INSTRUMENTS OF SERVICE SHALL NOT BE REPRODUCED, TRANSMITTED, DISCLOSED OR USED OTHERWISE IN WHOLE OR IN PART WITHOUT THE WRITTEN AGREEMENT BY AWS AND MUST BE RETURNED OR DESTROYED UPON REQUEST.

REV	REVISION DESCRIPTION	DRWN	CHKD	APP	DATE
A	ORIGINAL ISSUE	SS	JW	DP	NOV. 12
B	CUSTOMER COMMENTS ADDED	SS	JW	DP	JAN. 13
C	REVISED PER CUSTOMER COMMENTS	SS	JW	DP	MAY. 13
D	AS BUILT	SS	JW	DP	JUN. 13

REV	REVISION DESCRIPTION	DRWN	CHKD	APP	DATE

PROJECT INFORMATION
ZARGON LITTLE BOW ASP FACILITY
LSD 16-31-14-18 W4M
ALBERTA, CANADA
CONTRACT NUMBER
120128

ANDERSON
WATER SYSTEMS
44 Head St., Dundas, Ontario
L9H 3H3 Canada
Phone: +1 (905) 627-9233
www.AWSL.com

BY	DATE
DRWN SS	NOV. 12
CHKD JW	NOV. 12
APP DP	NOV. 12
REF	
SCALE	
TOTAL NUMBER OF LOOP PAGES:	17

CUSTOMER
DWG. No.

LOOP DIAGRAM
WEAK ACID CATION
UNITS V-153A/V-153B

SIZE
B

DWG. NO.
120128-0919-1-LOOP-012

REV
D

01 02 03 04 05 06 07 08 09 10

A
B
C
D
E
F
G
H
I



ISSUED FOR
SEP 19 2013
INFORMATION

THIS DRAWING AND ALL INFORMATION AND KNOWLEDGE CONTAINED OR REFERRED HEREIN ARE THE CONFIDENTIAL AND PROPRIETARY PROPERTY OF ANDERSON WATER SYSTEMS, INC. ("AWS") AND AS SUCH ARE INSTRUMENTS OF SERVICE FOR USE SOLELY WITH RESPECT TO THIS PROJECT. THESE INSTRUMENTS OF SERVICE SHALL NOT BE REPRODUCED, TRANSMITTED, DISCLOSED OR USED OTHERWISE IN WHOLE OR IN PART WITHOUT THE WRITTEN AGREEMENT BY AWS AND MUST BE RETURNED OR DESTROYED UPON REQUEST.


REV	REVISION DESCRIPTION	DRWN	CHKD	APP	DATE	REV	REVISION DESCRIPTION	DRWN	CHKD	APP	DATE
A	ORIGINAL ISSUE	SS	JW	DP	NOV. 12						
B	CUSTOMER COMMENTS ADDED	SS	JW	DP	JAN. 13						
C	REVISED PER CUSTOMER COMMENTS	SS	JW	DP	MAY. 13						
D	AS BUILT	SS	JW	DP	JUN. 13						

PROJECT INFORMATION
ZARCON LITTLE BOW ASP FACILITY
LSD 16-31-14-18 W4M
ALBERTA, CANADA
CONTRACT NUMBER
120128

ANDERSON WATER SYSTEMS
44 Head St., Dundas, Ontario
L9H 3H3 Canada
Phone: +1 (905) 627-9233
www.AWSL.com

BY	DATE
SS	NOV. 12
JW	NOV. 12
DP	NOV. 12

SIZE	DWG. NO.	REV.
B	120128-1105-1-LOOP-013	D

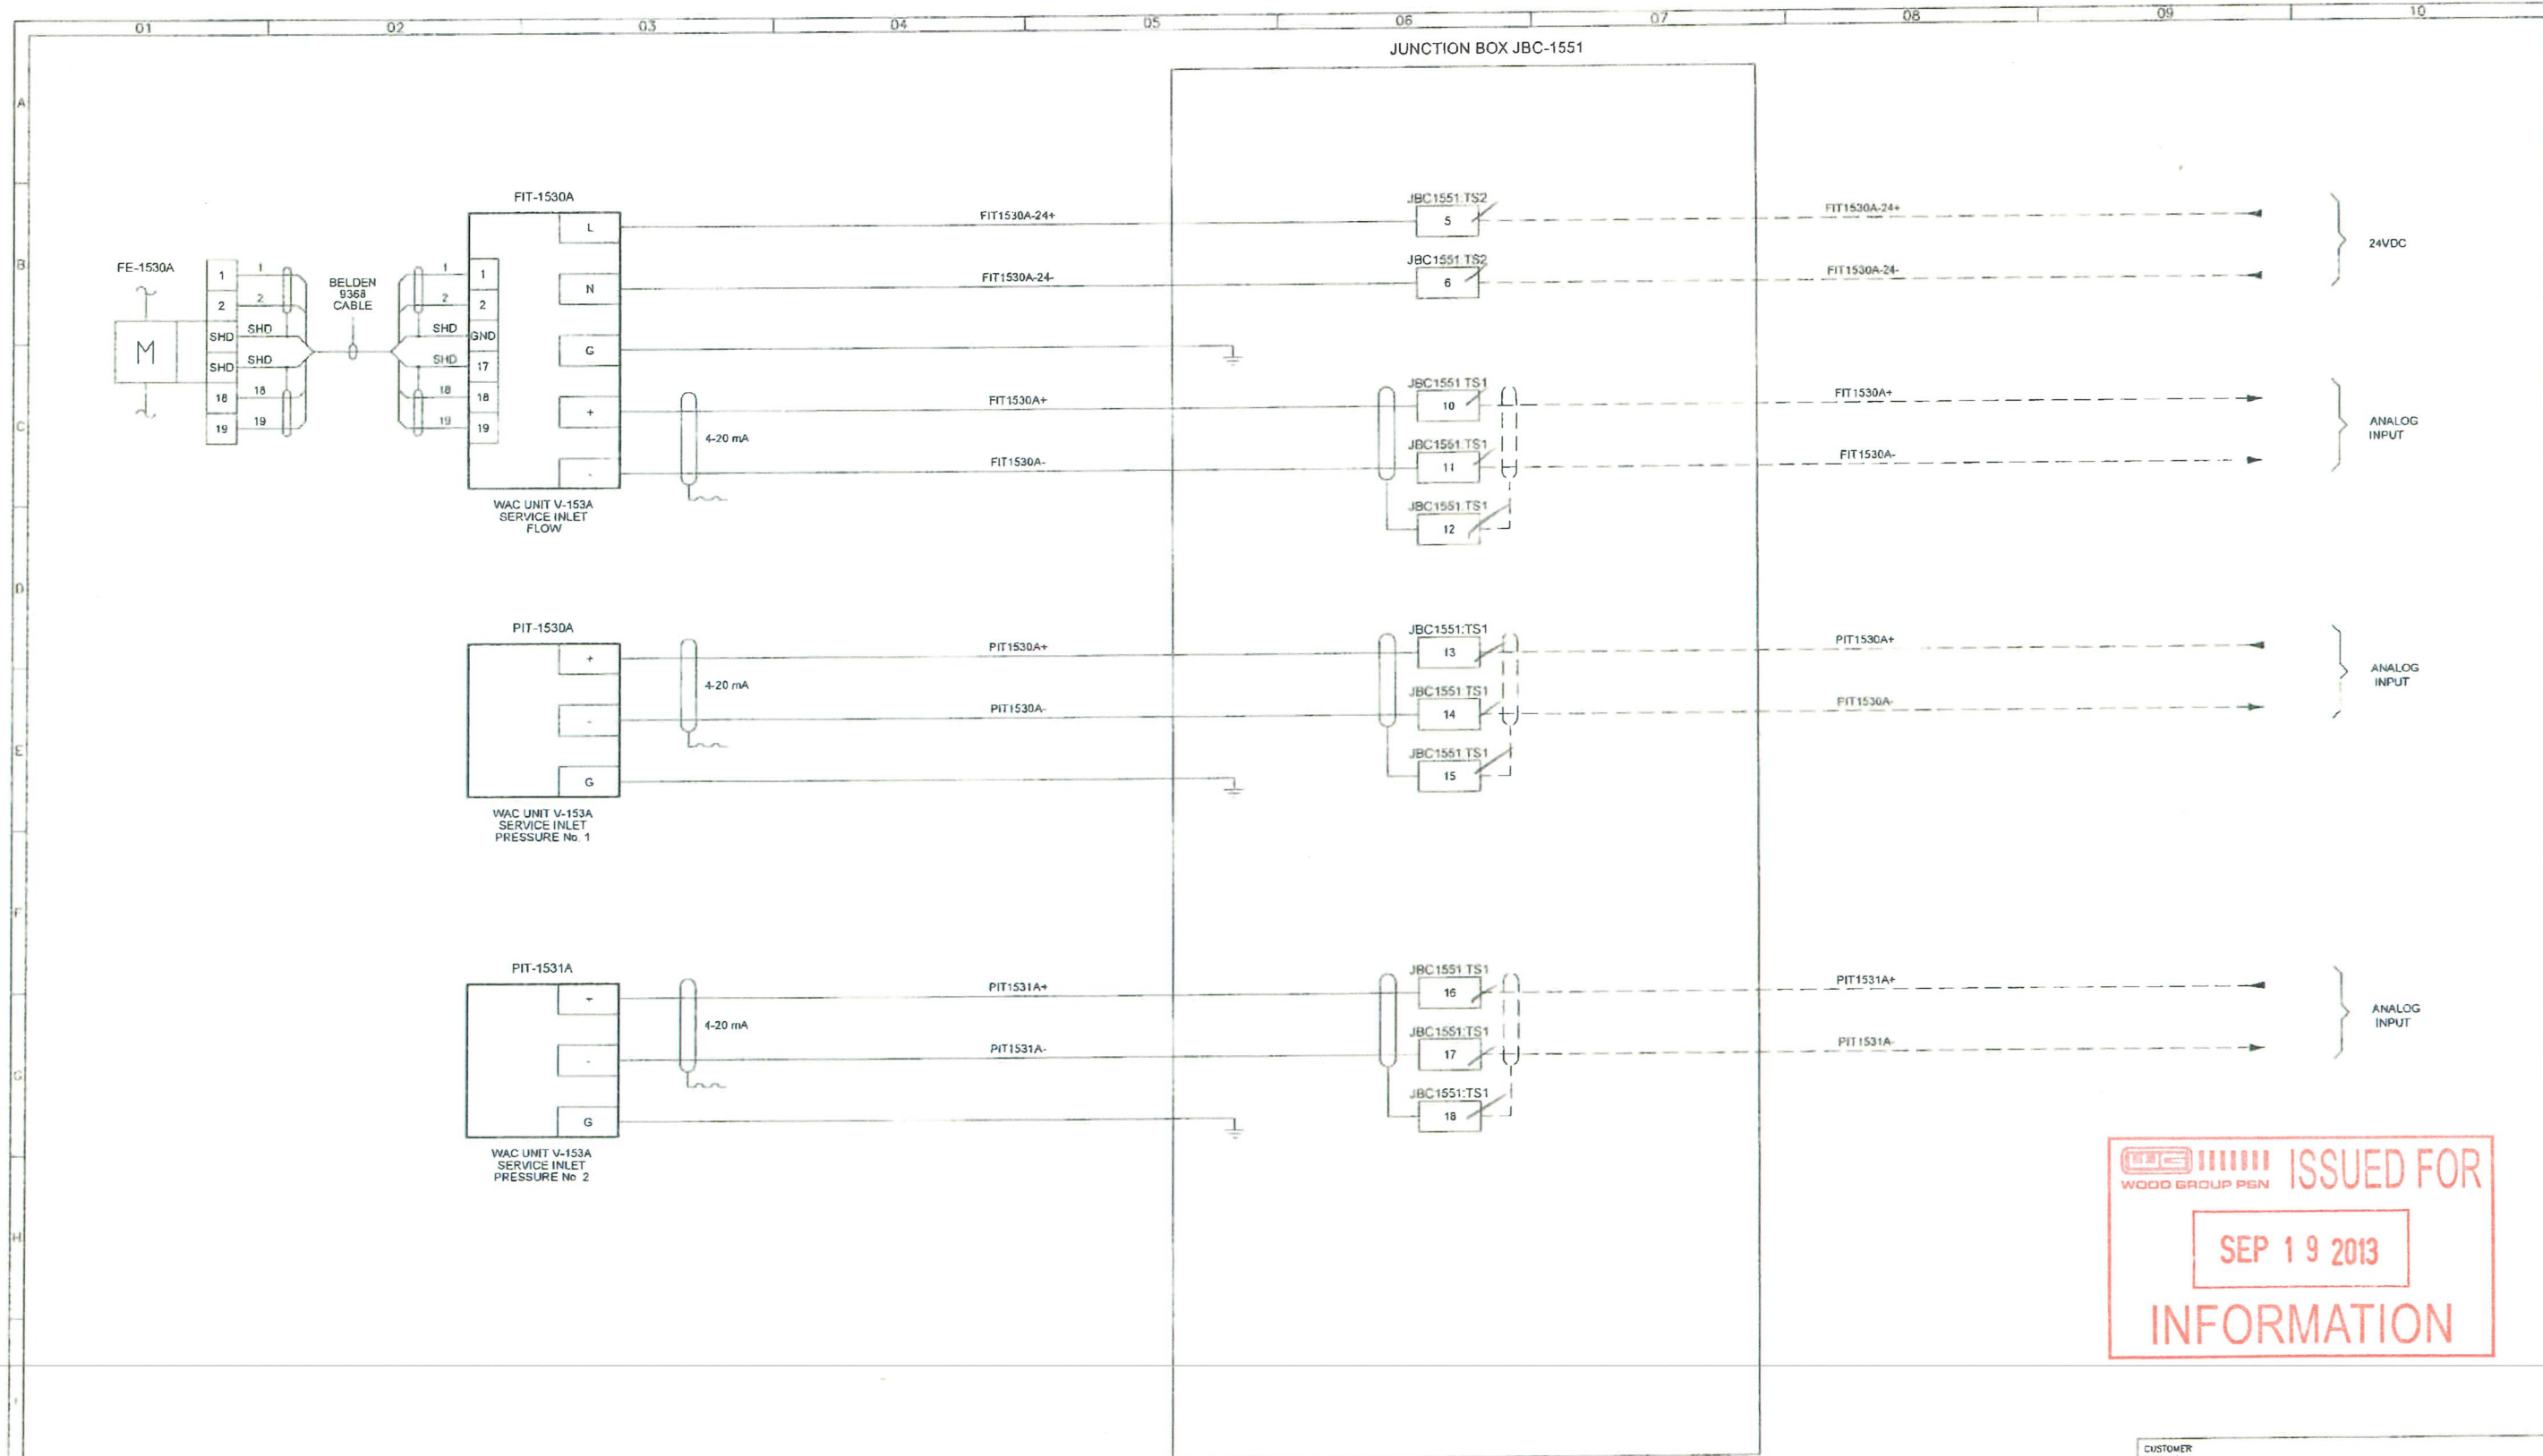

ISSUED FOR
SEP 19 2013
INFORMATION

THIS DRAWING AND ALL INFORMATION AND KNOWLEDGE CONTAINED OR REFERRED HEREIN ARE THE CONFIDENTIAL AND PROPRIETARY PROPERTY OF ANDERSON WATER SYSTEMS, INC. ("AWS") AND AS SUCH ARE INSTRUMENTS OF SERVICE FOR USE SOLELY WITH RESPECT TO THIS PROJECT. THESE INSTRUMENTS OF SERVICE SHALL NOT BE REPRODUCED, TRANSMITTED, DISCLOSED OR USED OTHERWISE IN WHOLE OR IN PART WITHOUT THE WRITTEN AGREEMENT BY AWS AND MUST BE RETURNED OR DESTROYED UPON REQUEST.

REV	REVISION DESCRIPTION	DRWN	CHKD	APP	DATE
A	ORIGINAL ISSUE	SS	JW	DP	NOV. 12
B	CUSTOMER COMMENTS ADDED	SS	JW	DP	JAN. 13
C	REVISED PER CUSTOMER COMMENTS	SS	JW	DP	MAY .13
D	AS BUILT	SS	JW	DP	JUN 13

REV	REVISION DESCRIPTION	DRWN	CHKD	APP	DATE

PROJECT INFORMATION
ZARGON LITTLE BOW ASP FACILITY
LSD 16-31-14-18 W4M
ALBERTA, CANADA
CONTRACT NUMBER
120128

ANDERSON WATER SYSTEMS
44 Head St., Dundas, Ontario
L9H 3H3 Canada
Phone: +1 (905) 627-9233
www.AWSL.com

BY	DATE
DRWN SS	NOV. 12
CHKD JW	NOV. 12
APP DP	NOV. 12
REF.	
SCALE	
TOTAL NUMBER OF LOOP PAGES	17

CUSTOMER DWS. No.	
LOOP DIAGRAM	
WEAK ACID CATION	
UNIT V-153A	
SIZE	B
DWG. NO.	120128-0919-1-LOOP-002
REV	D