


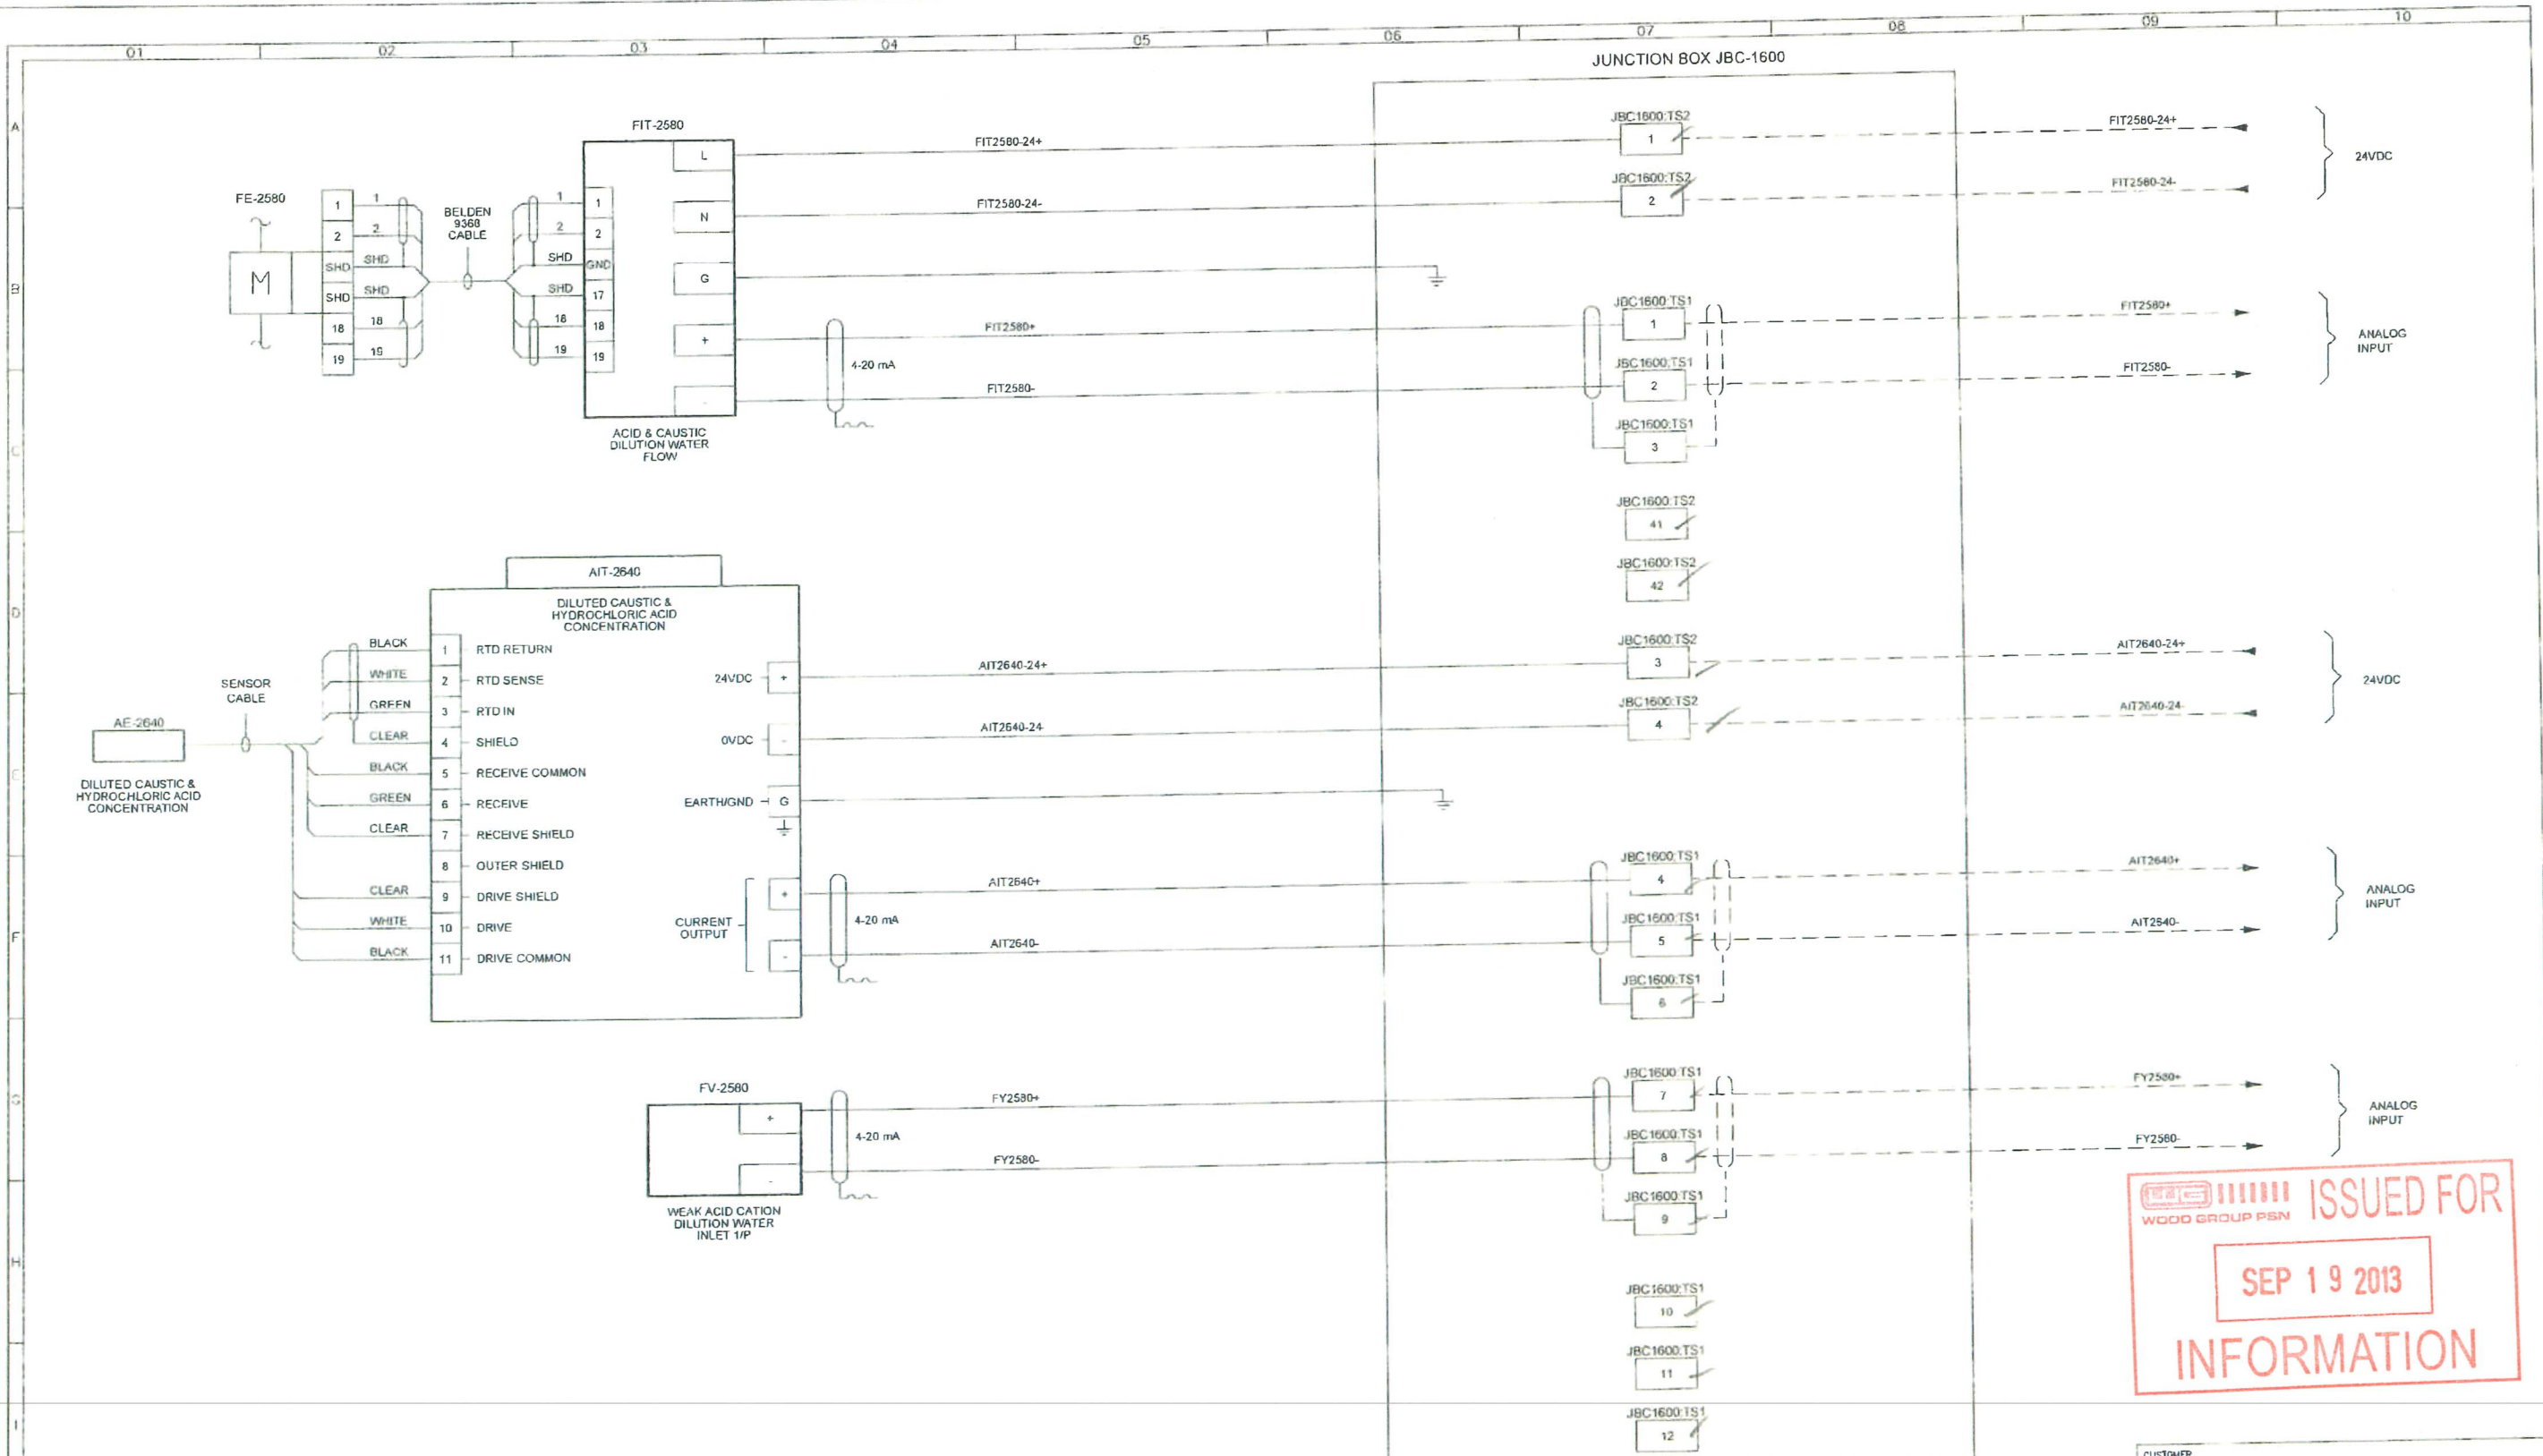

ISSUED FOR
 SEP 19 2013
 INFORMATION

THIS DRAWING AND ALL INFORMATION AND KNOWLEDGE CONTAINED OR REFERRED HEREIN ARE THE CONFIDENTIAL AND PROPRIETARY PROPERTY OF ANDERSON WATER SYSTEMS, INC. ("AWS") AND AS SUCH ARE INSTRUMENTS OF SERVICE FOR USE SOLELY WITH RESPECT TO THIS PROJECT. THESE INSTRUMENTS OF SERVICE SHALL NOT BE REPRODUCED, TRANSMITTED, DISCLOSED OR USED OTHERWISE IN WHOLE OR IN PART WITHOUT THE WRITTEN AGREEMENT BY AWS AND MUST BE RETURNED OR DESTROYED UPON REQUEST.

REV	REVISION DESCRIPTION	DRWN	CHKD	APP	DATE	REV	REVISION DESCRIPTION	DRWN	CHKD	APP	DATE
A	ORIGINAL ISSUE	SS	JW	DP	NOV. 12						
B	CUSTOMER COMMENTS ADDED	SS	JW	DP	JAN. 13						
C	REVISED PER CUSTOMER COMMENTS	SS	JW	DP	MAY 13						
D	AS BUILT	SS	JW	DP	JUN. 13						

PROJECT INFORMATION
 ZARGON LITTLE BOW ASP FACILITY
 LSD 16-31-14-18 W4M
 ALBERTA, CANADA
 CONTRACT NUMBER
 120128


ANDERSON WATER SYSTEMS
 44 Head St., Dundas, Ontario
 L9H 3H3 Canada
 Phone: +1 (905) 627-9233
 www.AWSL.com

BY	DATE	SIZE	DWG. NO.	REV.
DRWN	SS NOV. 12	B	120128-1115-1-LOOP-014	D
CHKD	JW NOV. 12			
APP	DP NOV. 12			
REF.				
SCALE				
TOTAL NUMBER OF LOOP PAGES	17			


CUSTOMER
 DWG. No.
 LOOP DIAGRAM
 WEAK ACID CATION
 DILUTION SKID

JUNCTION BOX JBC-1600


CAUSTIC REGEN SYSTEM
CAUSTIC BLOCK
LIMIT SWITCH OPEN

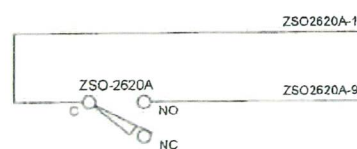


CAUSTIC REGEN SYSTEM
CAUSTIC BLOCK
LIMIT SWITCH CLOSED

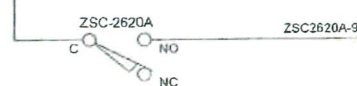


CAUSTIC REGEN SYSTEM
CAUSTIC BLOCK
SOLENOID VALVE

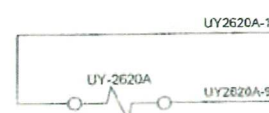


CAUSTIC REGEN SYSTEM
CAUSTIC BLOCK
LIMIT SWITCH OPEN

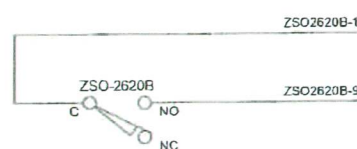


CAUSTIC REGEN SYSTEM
CAUSTIC BLOCK
LIMIT SWITCH CLOSED

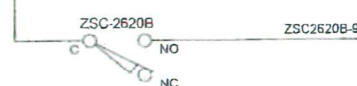


CAUSTIC REGEN SYSTEM
CAUSTIC BLOCK
SOLENOID VALVE

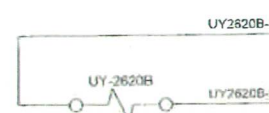



CAUSTIC REGEN SYSTEM
CAUSTIC BLEED
LIMIT SWITCH OPEN

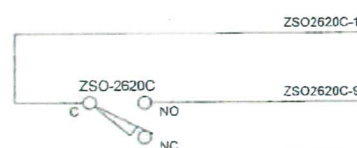

CAUSTIC REGEN SYSTEM
CAUSTIC BLEED
LIMIT SWITCH CLOSED

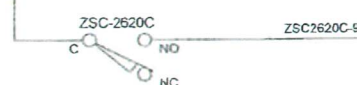

CAUSTIC REGEN SYSTEM
CAUSTIC BLEED
SOLENOID VALVE

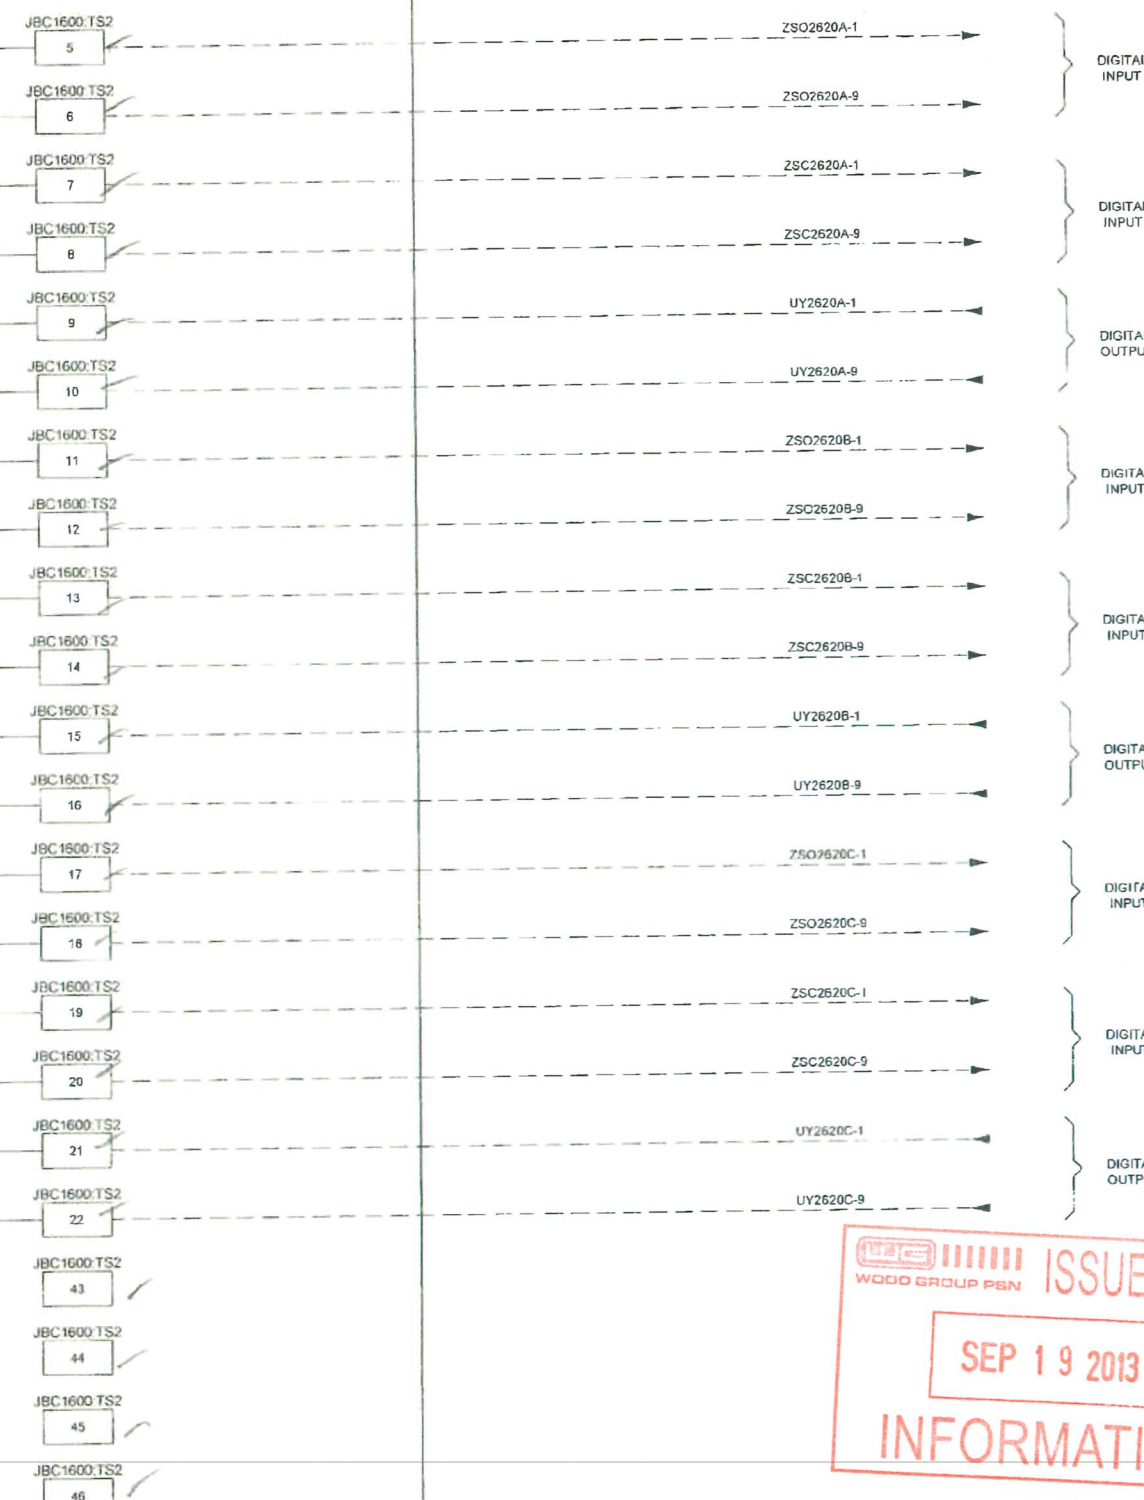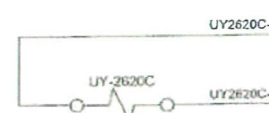

ISSUED FOR
SEP 19 2013
INFORMATION

THIS DRAWING AND ALL INFORMATION AND KNOWLEDGE CONTAINED OR REFERRED HEREIN ARE THE CONFIDENTIAL AND PROPRIETARY PROPERTY OF ANDERSON WATER SYSTEMS, INC. ("AWS") AND AS SUCH ARE INSTRUMENTS OF SERVICE FOR USE SOLELY WITH RESPECT TO THIS PROJECT. THESE INSTRUMENTS OF SERVICE SHALL NOT BE REPRODUCED, TRANSMITTED, DISCLOSED OR USED OTHERWISE IN WHOLE OR IN PART WITHOUT THE WRITTEN AGREEMENT BY AWS AND MUST BE RETURNED OR DESTROYED UPON REQUEST.

REV	REVISION DESCRIPTION	DRWN	CHKD	APP	DATE
A	ORIGINAL ISSUE	SS	JW	DP	NOV 12
B	CUSTOMER COMMENTS ADDED	SS	JW	DP	JAN 13
C	REVISED PER CUSTOMER COMMENTS	SS	JW	DP	MAY 13
D	AS BUILT	SS	JW	DP	JUN 13


REV	REVISION DESCRIPTION	DRWN	CHKD	APP	DATE

PROJECT INFORMATION
ZARGON LITTLE BOW ASP FACILITY
LSD 16-31-14-18 W4M
ALBERTA, CANADA
CONTRACT NUMBER
120128

ANDERSON WATER SYSTEMS
44 Head St., Dundas, Ontario
L9H 3H3 Canada
Phone: +1 (905) 627-9233
www.AWSL.com

BY	DATE
SS	NOV 12
JW	NOV 12
DP	NOV 12

CUSTOMER	DWG. No.
LOOP DIAGRAM	
WEAK ACID CATION	
DILUTION SKID	
SIZE	B
DWG. NO.	120128-1115-1-LOOP-015
REV	D

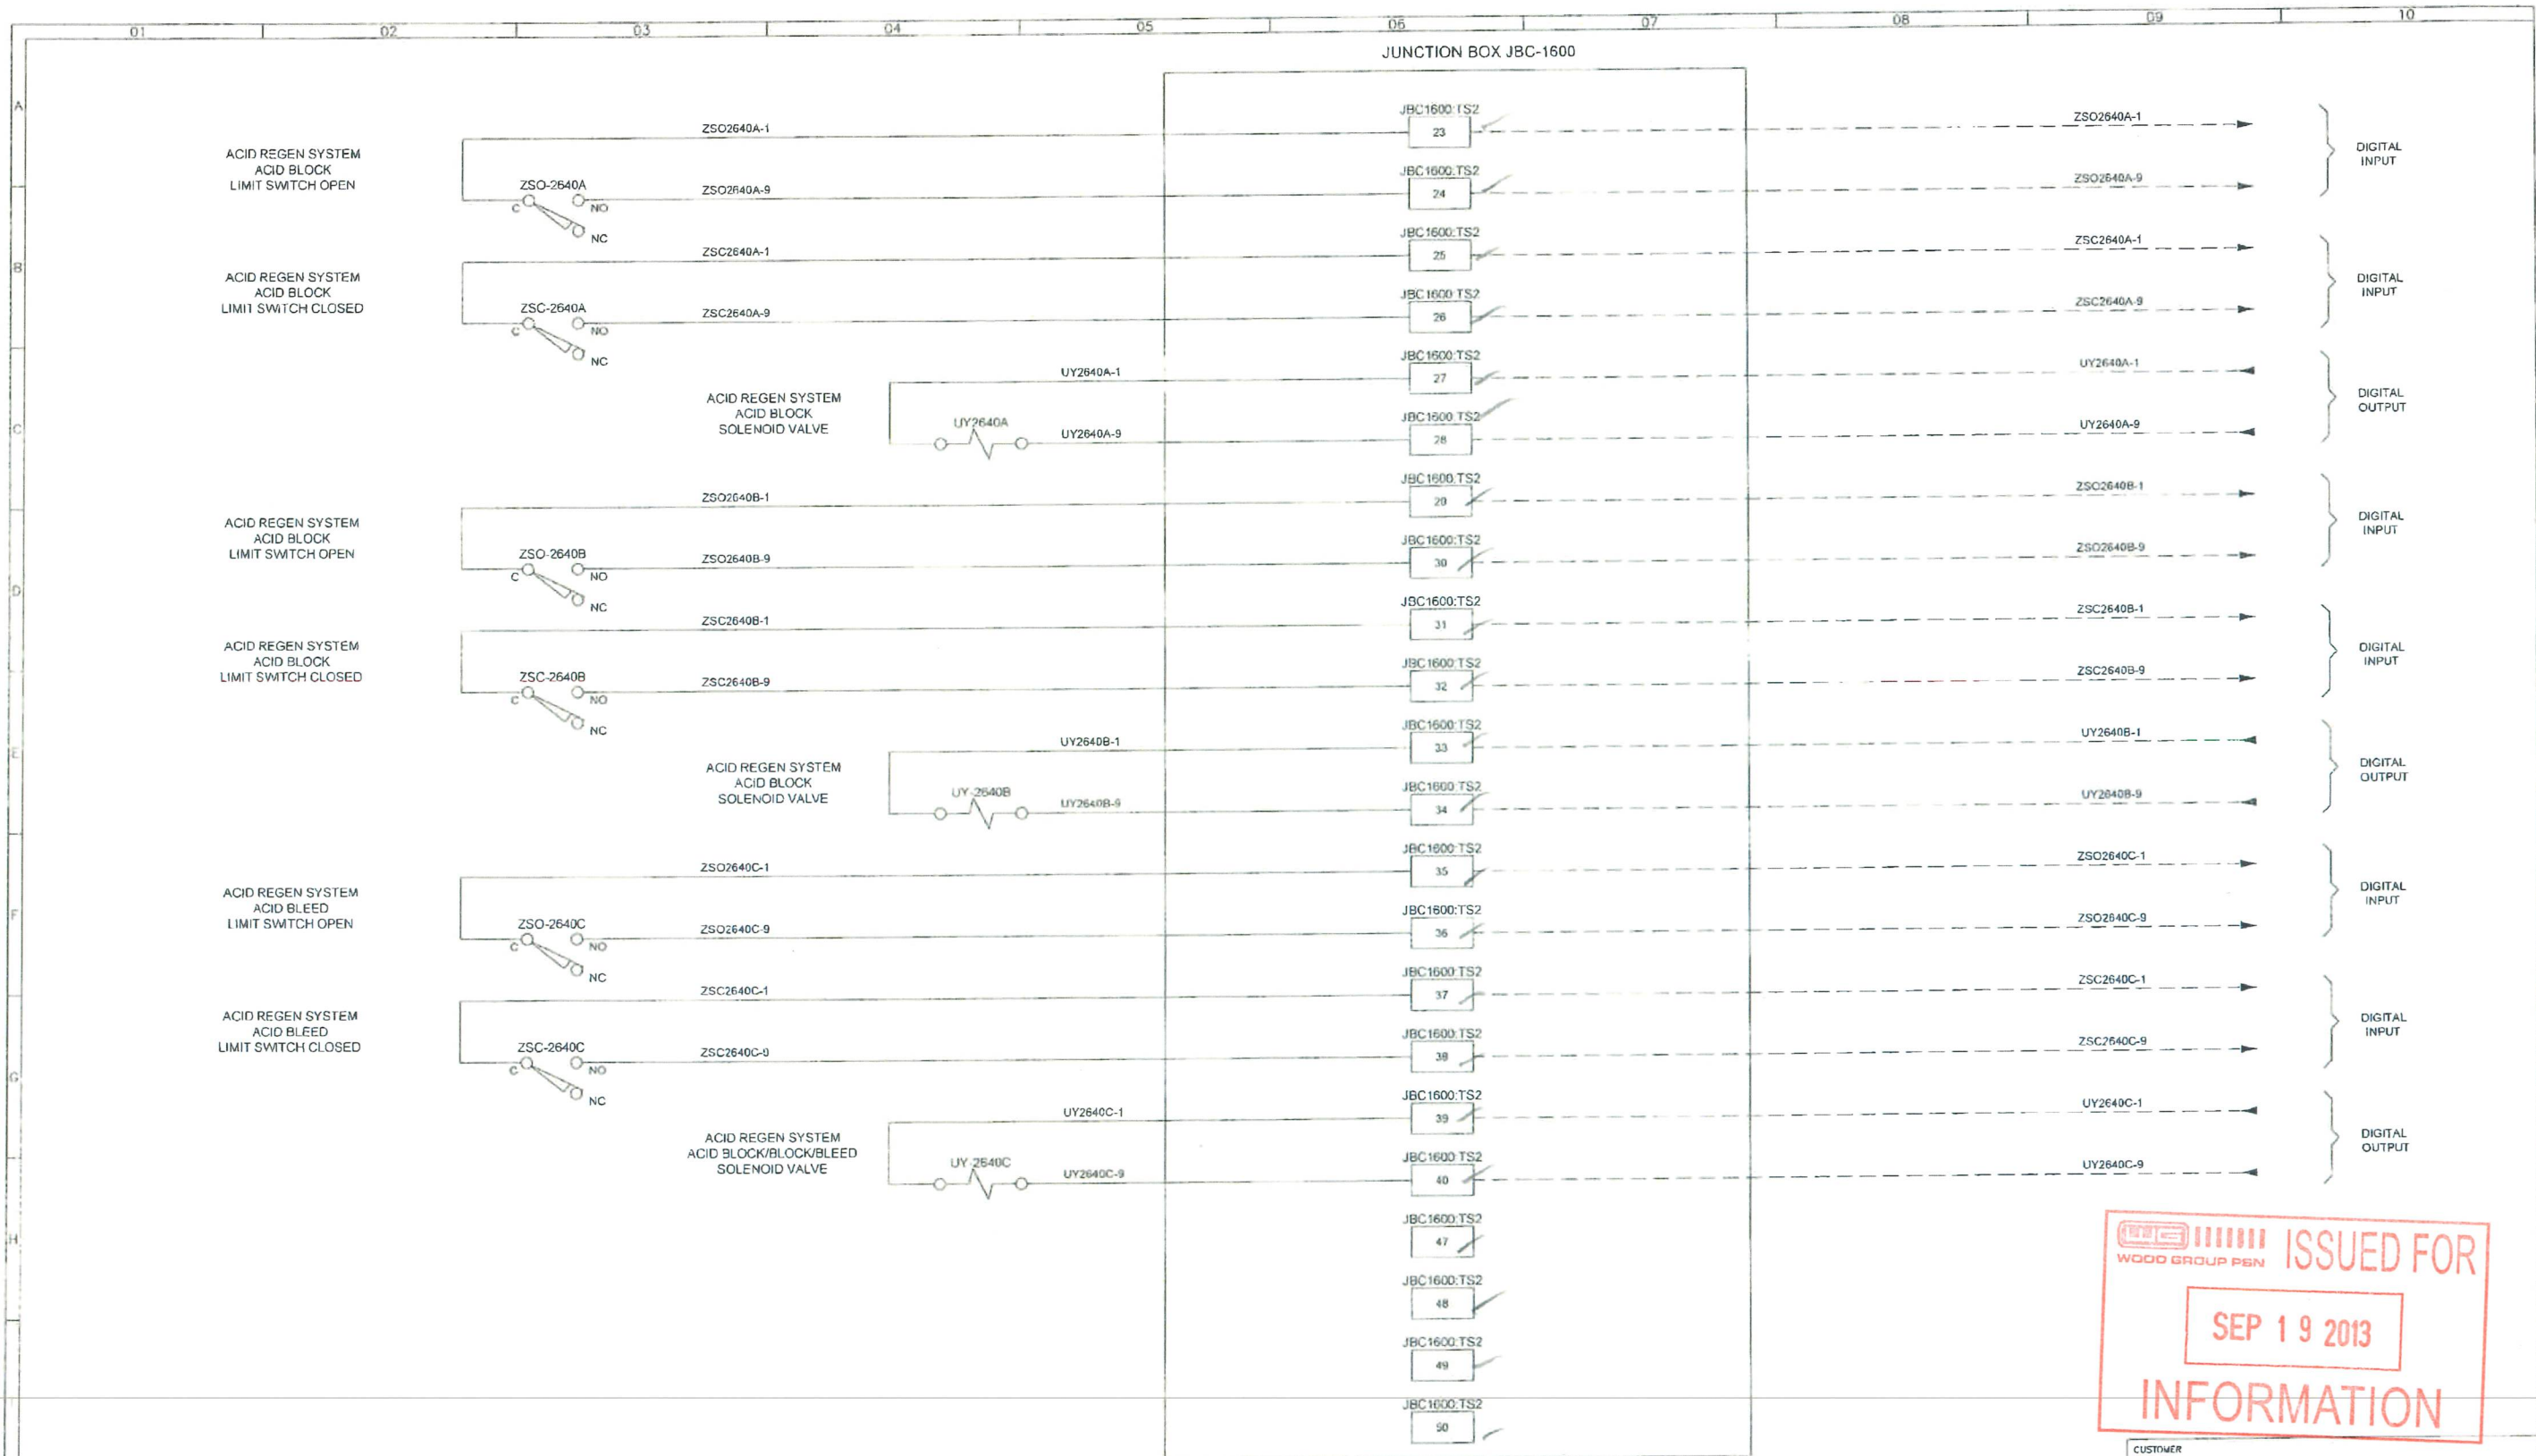

ISSUED FOR
SEP 19 2013
INFORMATION

THIS DRAWING AND ALL INFORMATION AND KNOWLEDGE CONTAINED OR REFERRED HEREIN ARE THE CONFIDENTIAL AND PROPRIETARY PROPERTY OF ANDERSON WATER SYSTEMS, INC. (AWS) AND AS SUCH ARE INSTRUMENTS OF SERVICE FOR USE SOLELY WITH RESPECT TO THIS PROJECT. THESE INSTRUMENTS OF SERVICE SHALL NOT BE REPRODUCED, TRANSMITTED, DISCLOSED OR USED OTHERWISE IN WHOLE OR IN PART WITHOUT THE WRITTEN AGREEMENT BY AWS AND MUST BE RETURNED OR DESTROYED UPON REQUEST.

REV	REVISION DESCRIPTION	DRWN	CHKD	APP	DATE
A	ORIGINAL ISSUE	SS	JW	DP	NOV. 12
B	CUSTOMER COMMENTS ADDED	SS	JW	DP	JAN. 13
C	REVISED PER CUSTOMER COMMENTS	SS	JW	DP	MAY. 13
D	AS BUILT	SS	JW	DP	JUN. 13

REV	REVISION DESCRIPTION	DRWN	CHKD	APP	DATE

PROJECT INFORMATION
 ZARGON LITTLE BOW ASP FACILITY
 LSD 16-31-14-18 W4M
 ALBERTA, CANADA
 CONTRACT NUMBER
 120128

ANDERSON WATER SYSTEMS
 44 Head St., Dundas, Ontario
 L9H 3H3 Canada
 Phone: +1 (905) 627-9233
 www.AWSL.com

BY	DATE	SIZE	REF.	SCALE	TOTAL NUMBER OF LOOP PAGES
SS	NOV. 12	B			17
JW	NOV. 12				
DP	NOV. 12				

CUSTOMER
 Dwg. No.
120128-1115-1-LOOP-016